

MISSISSIPPI DEPARTMENT OF ENVIRONMENTAL QUALITY

Office of Land and Water Resources

COUNTY WELL LOCATED
Leflore

WELL NUMBER **L-283** CODED

DATE WELL COMPLETED
4-29-03

PERMIT NUMBER
GW15947

NAME OF DRILLING FIRM
**Irrigation Equipment Inc.
Indianola, MS**

P. O. Box 10631
Jackson, MS 39289-0631
WATER WELL DRILLERS LOG

NAME & MAILING ADDRESS OF LANDOWNER
**Leflore County Board of Supervisors,
306 West Market St.
Greenwood, MS 38930**

Latitude:
Longitude:

WELL LOCATION: SEC 10 TOWNSHIP 19N RANGE 1E
SE/NW S E W

DISTANCE _____ MILES DIRECTION _____ NEAREST TOWN **Greenwood**

OTHER LANDMARK _____

WELL PURPOSE: Home, Irrigation, Municipal, Industrial, Fish Pond, etc.
Dewatering

PUMP DATA

PUMP TYPE (Circle One):
 Submersible, Turbine, Jet Flowing Well,
Other (Describe) _____

POWER TYPE (Circle One):
 Electric, Tractor, Diesel, Gasoline, Butane,
Other (Describe) _____ H/P **30**

DESCRIPTION OF FORMATIONS ENCOUNTERED	FROM	TO
Clay	0	25
Clay/fine sand	25	41
Fine Sand	41	60
Fine Sand/gravel	60	68
Med. Sand/gravel	68	100

WELL DATA

Well Depth 100	Casing Diameter (In.) 12	Casing Length (Ft.) 80
Type of Casing pvc	Hole Depth 100	Depth to Static Water Level
TYPE OF COMPLETION: (Circle One or More): <input checked="" type="radio"/> Gravel Packed, <input type="radio"/> Underreamed, <input type="radio"/> Telescoped, <input type="radio"/> Natural Development, <input type="radio"/> Open Hole, <input type="radio"/> Other (Describe) _____		

WELL GROUTED TO A DEPTH OF _____ FEET
Type Grout (circle one): Cement, Bentonite, or Mix

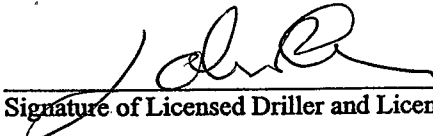
SCREEN DATA

Diameter - Inches 12	Length - Feet 20	Slot Size - Inches .050
Screen Type pvc	Depth to Bottom - Feet 100	

Top of Lap Pipe or Reduction in Casing
FEET IF TELESCOPED OR MORE THAN ONE SCREEN: USE BACK PAGE

RECEIVED
MAY 13 2003
BY: OLWR

I certify that the well was drilled, constructed and completed in accordance with all applicable Requirements of the Mississippi Department of Environmental Quality and/or the Mississippi Department of Health regulations and state laws.


Signature of Licensed Driller and License No. **0439**

5-9-03
Date

Additional Information Required On Back

If well telescopes please sketch and show depths.

GROUND LEVEL

	X		

SECTION 10

Please indicate well location X.

Pump Capacity (GPM)	No. of Stages	Setting Depth
1100	1	80 FT.

PUMP TEST

Well yielded _____ GPM with
a drawdown of _____ ft.
after _____ hours of pumping

LOG DATA

TYPE OF LOG RUN (Circle One): No Log Run,
Electric, Gamma Ray, Density, Sonic, Neutron,
Other (Describe) _____

Name of Organization Running Log _____

GEOLOGIC DATA (Office Use Only)

Surface Elev.	Geologic Unit	Unit Thickness	Depth to Top
Subs. SWL	Date	Analysis	Aquifer Test

Driller's Remarks

If more than one screen,
show location of each on sketch.