

**MISSISSIPPI DEPARTMENT OF ENVIRONMENTAL QUALITY**

Office of Land and Water Resources

P. O. Box 10631  
Jackson, MS 39289-0631  
**WATER WELL DRILLERS LOG**

COUNTY WELL LOCATED <u>Leflore</u>	
WELL NUMBER <u>1</u>	CODED
L-287	
DATE WELL COMPLETED <u>10-03</u>	

PERMIT NUMBER
NAME OF DRILLING FIRM <u>CBS Drilling</u>

NAME & MAILING ADDRESS OF LANDOWNER <u>JOE EARNEST</u> <u>704 BARTON AVE</u> <u>Greenwood, ms 38930</u>			
Latitude:			
Longitude:			
WELL LOCATION.	SEC	TOWNSHIP	RANGE
	<u>2</u>	<u>T-19</u>	<u>R-1</u>
DISTANCE	DIRECTION	NEAREST TOWN	
<u>4</u> Miles	<u>N</u>	of <u>Greenwood</u>	
OTHER LANDMARK			
WELL PURPOSE: Home, Irrigation, Municipal, Industrial, Fish Pond, etc. <u>HO SHOP</u>			

PUMP DATA			
PUMP TYPE (Circle One): <input checked="" type="radio"/> Submersible, Turbine, Jet, Flowing Well, Other (Describe) _____			
POWER TYPE (Circle One): <input checked="" type="radio"/> Electric, Tractor, Diesel, Gasoline, Butane, Other (Describe) _____ H/P <u>1</u>			

DESCRIPTION OF FORMATIONS ENCOUNTERED	FROM	TO
<u>TOP Soil &amp; Clay</u>	<u>0</u>	<u>12</u>
<u>SAwk</u>	<u>12</u>	<u>57</u>
<u>SAND &amp; GRAVEL</u>	<u>57</u>	<u>112</u>
<u>H. Shell</u>	<u>112</u>	<u>161</u>
<u>Shell &amp; Rocks</u>	<u>161</u>	<u>184</u>
<u>Shell</u>	<u>184</u>	<u>206</u>
<u>Green SAND</u>	<u>206</u>	<u>245</u>

WELL DATA		
Well Depth <u>242</u>	Casing Diameter (In.) <u>4</u>	Casing Length (Ft.) <u>222</u>
Type of Casing <u>PVC</u>	Hole Depth <u>245</u>	Depth to Static Water Level <u>8</u>
TYPE OF COMPLETION: (Circle One or More): <input checked="" type="radio"/> Gravel Packed, Underreamed, Telescoped, Natural Development, Open Hole, Other (Describe) _____		
WELL GROUTED TO A DEPTH OF <u>10</u> FEET Type Grout (circle one): Cement, Bentonite, or Mix		

SCREEN DATA		
Diameter - Inches <u>4</u>	Length - Feet <u>20</u>	Slot Size - Inches <u>10/10</u>
Screen Type <u>PVC</u>	Depth to Bottom - Feet <u>242</u>	

<b>RECEIVED</b>	
OCT 07 2003	
BY: OLWR	
Top of Lap Pipe or Reduction in Casing	FEET
	IF TELESCOPED OR MORE THAN ONE SCREEN: USE BACK PAGE

I certify that the well was drilled, constructed and completed in accordance with all applicable Requirements of the Mississippi Department of Environmental Quality and/or the Mississippi Department of Health regulations and state laws.


Calvin Sullivan D-537  
Signature of Licensed Driller and License No.

10-2-03  
Date

Additional Information Required On Back

If well telescopes please sketch and show depths.

GROUND LEVEL

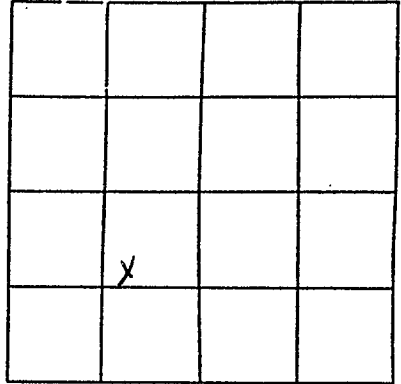

SECTION 2

Please indicate well location X.

Pump Capacity (GPM)	No. of Stages	Setting Depth	
20	9	63	FT.

PUMP TEST

Well yielded 28 GPM with  
a drawdown of 14 ft.  
after 12 hours of pumping

LOG DATA

TYPE OF LOG RUN (Circle One): No Log Run.  
Electric, Gamma Ray, Density, Sonic, Neutron,  
Other (Describe) \_\_\_\_\_

Name of Organization Running Log

GEOLOGIC DATA (Office Use Only)

Surface Elev.	Geologic Unit	Unit Thickness	Depth to Top
Subs. SWL	Date	Analysis	Aquifer Test

Driller's Remarks

If more than one screen,  
show location of each on sketch.