	<b>State Well</b>	Report	
county: Leflore	Part 1 Mississippi Department of Environmental Quality		For Office Use Only:
			Aquifer:
Permit #: $(e W 4/05 l_{0})$	Office of Land and Water Resources		Well #: 1 - 297
Irrigation Equipment	P.O. Box		
	Jackson, MS 39289-0631		L. S. Elevation:
Date drilling completed: $5 - 3 - 06$	(601)961- (601)354-69		E-log #:
	] (001)554-05	56 (1ax)	L-log #.
State Law requires that this rep	ort be prepared by the dril	ler in detail and filed w	ith the Department within
30 days of completion of drilling	of the well.		
Well Owner Information		Well Location	
Owner Name Mike Bussey Latitude:		itude: 33 30 50.5	" Longitude: <u>90</u> .06,13.3
Mailing Address: Rt.1, Box	<u>574A</u> Me	thod of Lat/Long (circle or	e): Conventional Survey,
		USGS quad. Hand-held	GPS, Survey-grade GPS
		<u>SE14</u> <u>SE14</u> <u>Sec</u> 17 <u>Twn 19N</u> <u>Rng 2E</u>	
	NG 20020	2114 Stor Sec_ 17	Twn_I9NRng_2E
<u>Greenwood</u> City Sta	<u>MS 38930</u>	stance Direction	Nearest Town
2			of <u>Greenwood</u>
Telephone No. ()	I		
	Well Data		
Purpose of Well (circle one) Home Ind	ustrial Public Supply	igation Fish Culture (	Other: Replacement
5.2	06		<u> </u>
Date well drilling started: $5-3-$	00 Date well of	Irilling completed:	5-3-06
If flowing, method of flow regulation: Va	lve Other (descri	ha)	
		UC )	
10'			
Static Water Level: feet al			
	pove or below (circle one) land	surface Date measured:	5-3-06
Method of Measurement (circle one)	pove or below (circle one) land teel tape electric tape	surface Date measured: air line other:	5-3-06
Method of Measurement (circle one)	pove or below (circle one) land teel tape electric tape	surface Date measured: air line other:	5-3-06
Static Water Level: <u>10'</u> feet al Method of Measurement (circle one) Hole depth: <u>117</u> Well de Type of grout (circle one); Cement	pove or below (circle one) land teel tape electric tape pth: <u>117</u>	surface Date measured: air line other:	5-3-06
Method of Measurement (circle one) ( Hole depth: <u>117</u> Well de Type of grout (circle one): Cement	pove or below (circle one) land teel tape electric tape pth: <u>117</u> W Bentonite Mix	surface Date measured: air line other: Vell grouted to a depth of	5-3-06 10feet
Method of Measurement (circle one)	bove or below (circle one) land teel tape electric tape pth: <u>117</u> W Bentonite Mix ng diameter: <u>16</u> ind	surface Date measured:_ air line other: Vell grouted to a depth of ches Type of casing:	5-3-06 10 feet PVC Sch.40
Method of Measurement (circle one) Hole depth: <u>117</u> Well de Type of grout (circle one): Cement Casing length: <u>77</u> feet Casi	bove or below (circle one) land teel tape electric tape pth: <u>117</u> W Bentonite Mix ng diameter: <u>16</u> ind	surface Date measured:_ air line other: Vell grouted to a depth of ches Type of casing:	5-3-06 10 feet PVC Sch.40
Method of Measurement (circle one) (* Hole depth: <u>117</u> Well de Type of grout (circle one): Cement Casing length: <u>77</u> feet Casi Screen length: <u>40</u> feet Screen	bove or below (circle one) land teel tape electric tape pth: <u>117</u> W Bentonite Mix ng diameter: <u>16</u> in teen diameter: <u>16</u> in	surface Date measured: air line other: Vell grouted to a depth of ches Type of casing: ches Type of screen:	5-3-06 <u>10</u> feet PVC Sch. 40 PVC Sch. 40
Method of Measurement (circle one) Hole depth: <u>117</u> Well de Type of grout (circle one): Cement Casing length: <u>77</u> feet Casi	bove or below (circle one) land teel tape electric tape pth: <u>117</u> W Bentonite Mix ng diameter: <u>16</u> in teen diameter: <u>16</u> in	surface Date measured: air line other: Vell grouted to a depth of ches Type of casing: ches Type of screen:	5-3-06 <u>10</u> feet PVC Sch. 40 PVC Sch. 40
Method of Measurement (circle one) Hole depth: <u>117</u> Well de Type of grout (circle one): Cement Casing length: <u>77</u> feet Casi Screen length: <u>40</u> feet Scree Screen slot size: <u>050</u> inches	bove or below (circle one) land teel tape electric tape pth: <u>117</u> W Bentonite Mix ng diameter: <u>16</u> in sen diameter: <u>16</u> in Setting depth: From	surface  Date measured:	5-3-06 <u>10</u> feet <u>PVC Sch.40</u> <u>PVC Sch.40</u> <u>17</u> feet
Method of Measurement (circle one) (* Hole depth: <u>117</u> Well de Type of grout (circle one): Cement Casing length: <u>77</u> feet Casi Screen length: <u>40</u> feet Screen	bove or below (circle one) land teel tape electric tape pth: <u>117</u> W Bentonite Mix ng diameter: <u>16</u> in sen diameter: <u>16</u> in Setting depth: From Gravel packed Underrean	surface  Date measured:	5-3-06 10 feet PVC Sch. 40 PVC Sch. 40 17 feet hole Natural Development
Method of Measurement (circle one) Hole depth: <u>117</u> Well de Type of grout (circle one): Cement Casing length: <u>77</u> feet Casi Screen length: <u>40</u> feet Scree Screen slot size: <u>050</u> inches	bove or below (circle one) land teel tape electric tape pth: <u>117</u> W Bentonite Mix ng diameter: <u>16</u> in sen diameter: <u>16</u> in Setting depth: From	surface  Date measured:	5-3-06 10 feet PVC Sch. 40 PVC Sch. 40 17 feet hole Natural Development
Method of Measurement (circle one) Hole depth: <u>117</u> Well de Type of grout (circle one): Cement Casing length: <u>77</u> feet Casi Screen length: <u>40</u> feet Scree Screen slot size: <u>050</u> inches Type of completion (circle all applicable):	bove or below (circle one) land teel tape electric tape pth: <u>117</u> W Bentonite Mix ng diameter: <u>16</u> in sen diameter: <u>16</u> in Setting depth: From Gravel packed Underrean Other (describe):	surface  Date measured:	5-3-06    10  feet    PVC Sch.40    PVC Sch.40    17  feet    hole  Natural Development
Method of Measurement (circle one) Hole depth: <u>117</u> Well de Type of grout (circle one): Cement Casing length: <u>77</u> feet Casi Screen length: <u>40</u> feet Scree Screen slot size: <u>050</u> inches Type of completion (circle all applicable):	bove or below (circle one) land teel tape electric tape pth: <u>117</u> W Bentonite Mix ng diameter: <u>16</u> in sen diameter: <u>16</u> in Setting depth: From Gravel packed Underrean Other (describe):	surface  Date measured:	5-3-06    10  feet    PVC Sch.40    PVC Sch.40    17  feet    hole  Natural Development
Method of Measurement (circle one) Hole depth: <u>117</u> Well de Type of grout (circle one): Cement Casing length: <u>77</u> feet Casi Screen length: <u>40</u> feet Scree Screen slot size: <u>050</u> inches	bove or below (circle one) land teel tape electric tape pth: <u>117</u> W Bentonite Mix ng diameter: <u>16</u> into teen diameter: <u>16</u> into Setting depth: From Gravel packed Underream Other (describe): feet. If telesco	surface  Date measured:	5-3-06 10 feet PVC Sch. 40 PVC Sch. 40 17 feet hole Natural Development een, describe on back of page
Method of Measurement (circle one) Hole depth: <u>117</u> Well de Type of grout (circle one): Cement Casing length: <u>77</u> feet Casi Screen length: <u>40</u> feet Scree Screen slot size: <u>050</u> inches Type of completion (circle all applicable): Top of lap pipe or reduction in casing: Logs run (circle all applicable): No log ru Name of organization running log(s):	bove or below (circle one) land teel tape electric tape pth: <u>117</u> W Bentonite Mix ng diameter: <u>16</u> into teen diameter: <u>16</u> into Setting depth: From Gravel packed Underrean Other (describe): feet. If telesco m Electric Gamma Ray De	surface  Date measured:	5-3-06    10  feet    PVC Sch.40    PVC Sch.40    17  feet    hole  Natural Development    een, describe on back of page    Other:
Method of Measurement (circle one) Hole depth: <u>117</u> Well de Type of grout (circle one): Cement Casing length: <u>77</u> feet Casi Screen length: <u>40</u> feet Scree Screen slot size: <u>050</u> inches Type of completion (circle all applicable): Top of lap pipe or reduction in casing: Logs run (circle all applicable): No log ru Name of organization running log(s): I certify that the well was drilled, constit	bove or below (circle one) land teel tape electric tape pth: <u>117</u> W Bentonite Mix ng diameter: <u>16</u> in sen diameter: <u>16</u> in Setting depth: From Gravel packed Underrean Other (describe): feet. If telesco m Electric Gamma Ray Do	surface  Date measured:	5-3-06    10  fcet    PVC Sch.40    PVC Sch.40    17  fcet    hole  Natural Development    cen, describe on back of page    Other:
Method of Measurement (circle one) Hole depth: <u>117</u> Well de Type of grout (circle one): Cement Casing length: <u>77</u> feet Casi Screen length: <u>40</u> feet Scree Screen slot size: <u>050</u> inches Type of completion (circle all applicable): Top of lap pipe or reduction in casing: Logs run (circle all applicable): No log ru Name of organization running log(s):	bove or below (circle one) land teel tape electric tape pth: <u>117</u> W Bentonite Mix ng diameter: <u>16</u> in sen diameter: <u>16</u> in Setting depth: From Gravel packed Underrean Other (describe): feet. If telesco m Electric Gamma Ray Do	surface  Date measured:	5-3-06    10  fcet    PVC Sch.40    PVC Sch.40    17  fcet    hole  Natural Development    cen, describe on back of page    Other:
Method of Measurement (circle one) Hole depth: <u>117</u> Well de Type of grout (circle one): Cement Casing length: <u>77</u> feet Casi Screen length: <u>40</u> feet Scree Screen slot size: <u>050</u> inches Type of completion (circle all applicable): Top of lap pipe or reduction in casing: Logs run (circle all applicable): No log ru Name of organization running log(s): I certify that the well was drilled, constu	bove or below (circle one) land teel tape electric tape pth: <u>117</u> W Bentonite Mix ng diameter: <u>16</u> into teen diameter: <u>16</u> into teen diameter: <u>16</u> into Setting depth: From Gravel packed Underrean Other (describe): feet. If telesco m Electric Gamma Ray Do ructed, and completed in acco and/or the Mississippi Depart	surface  Date measured:	5-3-06    10  fcet    PVC Sch.40    PVC Sch.40    17  fcet    hole  Natural Development    cen, describe on back of page    Other:
Method of Measurement (circle one) Hole depth: <u>117</u> Well de Type of grout (circle one): Cement Casing length: <u>77</u> feet Casi Screen length: <u>40</u> feet Screen Screen slot size: <u>050</u> inches Type of completion (circle all applicable): Top of lap pipe or reduction in casing: Logs run (circle all applicable): No log run Name of organization running log(s): I certify that the well was drilled, constituted to the state of t	bove or below (circle one) land teel tape electric tape pth: <u>117</u> W Bentonite Mix ng diameter: <u>16</u> into teen diameter: <u>16</u> into teen diameter: <u>16</u> into Setting depth: From Gravel packed Underrean Other (describe): feet. If telesco m Electric Gamma Ray Do ructed, and completed in acco and/or the Mississippi Depart	surface  Date measured:	5-3-06    10  fcet    PVC Sch.40    PVC Sch.40    17  fcet    hole  Natural Development    cen, describe on back of page    Other:

.


RECENTO MARIAN RACAR If well telescopes please sketch below and show depths.

× 1 4

Ground Level

Description of Formations Encountered	From To
Clay Fine Sand	0 33 34 49
Fine Sand/gravel Med. Sand/gravel	
Med. Sand/gravel	69 117

If more than one screen, show location of each on sketch

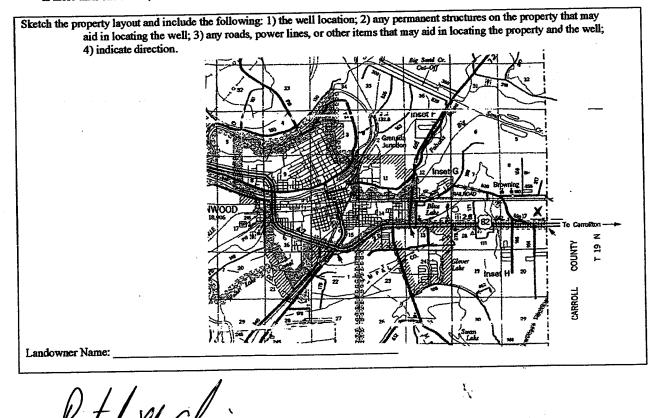

Signature of Water Well Contractor

	STATE W	ELL REPORT		
County: Leflore Permit # (00) 41056 Irrigation Equipment Driller: Date completed: 5-3-06 Copy information from block on Part 1	Part 2 Pump Installer's Completion Report Mississippi Department of Environmental Quality Office of Land and Water Resources P.O. Box 10631 Jackson, MS 39289-0631 (601)961-5210 (601)354-6938 (fax)		For Office Use Only: Aquifer: Well #: Elevation:	
This part of the report must be completed b report must be attached and both parts filed	y a licensed water well I with the Department	l contractor or a licensed pump at the above address within 30 (	installer. A copy of Part 1 of the laws of well completion.	
Vell Owner Informatio	m	We	Il Location	
Owner Name:Mike Bussey		Latitude:	_Longitude:	
Mailing Address: Rt.1, Box 574A Greenwood, MS 38930 City State Zip Code		Method of Lat/Long (check one): Conventional Survey		
		USGS quad, Hand-held GPS, Survey-grade GPS_		
		<u>SE ¼ SE ¼ Sec 17 T 19N R 2E</u>		
		Distance Direction Nearest Town		
Telephone No. ()		3 Miles East	of Greenwood	
Pump Type Circle one			ower Type Circle one	
Air Lift Jet	Submersible	Desel Engine Gasol	ine Engine Natural G	
	Turbine	Electric Motor Hand		
· · · ·	$\bigcirc$			
Centrifugal Rotary	Flowing Well		(specify):	
Other (specify):		Horse Power Rating of Moto	or	
Date Pump Installed:5-3-	06	Setting Depth:	50 feet	
·	Gallons Per Minute	Number of Stages:	2	
Pump Test Data		Method of Measuring Water Level Circle one		
Date Well Tested:	·····		easuring Line Steel Tape	
Static Water Level (A):Feet Below Land Surface		j	Ū I	
Pumping Water Level (B):Feet E		Other (specify):		
Drawdown [(B) - (A)]:Feet 1		For flowing well, measured shut in head:fe		
Test Pumping Rate:		Well yielded GPM with a drawdown of		
Duration of Pump Test (minimum 4 hours):			hours of pump	
I HEREBY CERTIFY that the above statem	anto ano tino ta the hee	t of my knowledge		

. .

RECEIVED Mar 232008 BY OLWH