


LeFlore  
 L 2000  
 7-14-75

MISSISSIPPI  
 BOARD OF WATER COMMISSIONERS  
 416 North State Street  
 Jackson, Mississippi 39201

WATER WELL DRILLERS LOG

July 14 1975 Bruce Berryman. LeFlore  
 date well completed firm name county well located  
 Greenwood, Miss.


| LANDOWNER: Bunch Concrete & Engineering Inc.<br>Hwy 49S.P.O. Box 160<br>Greenwood, Miss. 38930<br>(mailing address) | description of fomations encountered | from | to  |
|---------------------------------------------------------------------------------------------------------------------|--------------------------------------|------|-----|
|                                                                                                                     | Clay                                 | 0    | 20  |
|                                                                                                                     | Sand & Gravel                        | 20   | 140 |
|                                                                                                                     | Clay                                 | 140  | 150 |
| <b>WELL LOCATION:</b>                                                                                               |                                      |      |     |
| sec. 21 T. 19 N. R. 1 E. 15 J                                                                                       |                                      |      |     |
| 2 miles S of GREENWOOD<br>(distance) (direction) (nearest town)                                                     |                                      |      |     |
| <b>WELL PURPOSE:</b> for gravel yard<br>(home, irrigation, municipal, industrial)                                   |                                      |      |     |
| <b>WELL COMPLETION DATA:</b>                                                                                        |                                      |      |     |
| (1) diameter (inches) 4"                                                                                            |                                      |      |     |
| (2) total depth (feet) 130 ft.                                                                                      |                                      |      |     |
| (3) static water level (feet) 16' <sup>below</sup> <del>above</del> top of ground P.V.C                             |                                      |      |     |
| (4) casing Schedule 40 120'<br>(material) (depth)                                                                   |                                      |      |     |
| _____ if telescope see back.<br>(size)                                                                              |                                      |      |     |
| (5) screen 10' 120'<br>(length) (depth to top)                                                                      |                                      |      |     |
| 2" .010 Stainless steel<br>(size) (material)                                                                        |                                      |      |     |
| (6) pump 1 h.p. 19 g.p.m.<br>(HP) (yield gpm)                                                                       |                                      |      |     |
| Electric<br>(type power)                                                                                            |                                      |      |     |
| (7) electric log No<br>(yes or no)                                                                                  |                                      |      |     |
| _____<br>(organization running log)                                                                                 |                                      |      |     |
| (8) how well bottom plugged B.P.V.                                                                                  |                                      |      |     |
| <b>DRILLERS REMARKS:</b>                                                                                            |                                      |      |     |

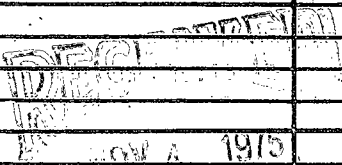

MISSISSIPPI BOARD OF WATER COMMISSIONERS

If well telescopes please sketch and show depths.

GROUND LEVEL

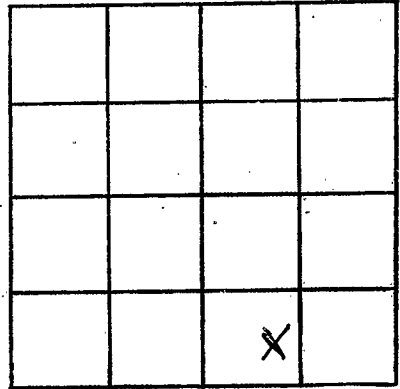

SECTION 21

Please indicate well location X.

ADDITIONAL INFORMATION

If more than one screen,  
show locations of each on sketch.