

LEFLORE
L 2004
3-12-76

MISSISSIPPI
 BOARD OF WATER COMMISSIONERS
 416 North State Street
 Jackson, Mississippi 39201

WATER WELL DRILLERS LOG

March 12 19 76 Bruce Berryman Leflore
 date well completed firm name county well located
 Greenwood,

LANDOWNER: Another RATLIFF
Rt. 1. Box 34
Greenwood, Miss.
 (mailing address)

WELL LOCATION:
 sec. 23 T. 19 N. R. 1 E
1 3/4 miles S of Greenwood
 (distance) (direction) (nearest town)

WELL PURPOSE: Home
 (home, irrigation, municipal, industrial)

WELL COMPLETION DATA:
 (1) diameter (inches) 4" x 2"
 (2) total depth (feet) 310 ft.
 (3) static water level (feet) flow ~~static~~ above top of ground.
 (4) casing 4" blk = 105 ft.
2" galv = 194 ft.
 (material) (depth)
 (size) If telescope see back.
 (5) screen 10 ft. 300 ft.
 (length) (depth to top)
.010 stainless steel
 (size) (material)
 (6) pump 3/4 h.p. 19
 (HP) (yield gpm)
Electric
 (type power)
 (7) electric log No
 (yes or no)
 (organization running log)
 (8) how well bottom plugged B.P.V.


description of fomations encountered	from	to
Clay	0	15
Sand	15	140
Clay	140	220
Shale	220	240
Green shale & sand	240	260
Shale	260	280
Sand	280	310
Shale	310	330

RECEIVED
 MAY 18 1976
 MISS. RD. OF WATER COMMISSIONERS

DRILLERS REMARKS:

If well telescopes please
sketch and show depths.

GROUND LEVEL

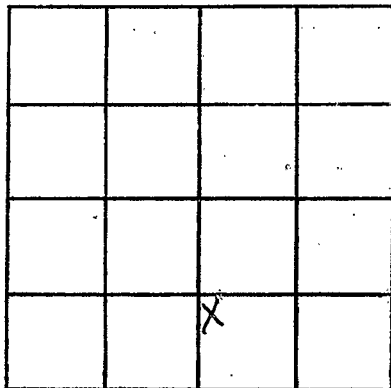

SECTION 23

Please indicate well location X.

ADDITIONAL INFORMATION

If more than one screen,
show locations of each on sketch.