

Leflore
 L 2005
 4/23/76

150

MISSISSIPPI
 BOARD OF WATER COMMISSIONERS
 416 North State Street
 Jackson, Mississippi 39201

WATER WELL DRILLERS LOG

April 23 1976

Bruce Berryman

Leflore

date well completed

firm name
 Greenwood, Miss.

county well located

LANDOWNER:	description of formations encountered	from	to	
Eddie Howze, Hwy 82 E, Greenwood, Miss. (mailing address)				Clay
WELL LOCATION: sec. 18 T 19 R 2 E 2 miles E of Greenwood (distance) (direction) (nearest town)	Sand	20	130	
	Clay	130	220	
	Green sand	220	260	
	Sandy shale	260	310	
	Green sand	310	360	
	Brown sand	360	380	
	Clay	380	400	
	Shale	400	450	
	Shale & Str. sand	450	520	
	WELL PURPOSE: HOME (home, irrigation, municipal, industrial)	Sand	520	560
WELL COMPLETION DATA: (1) diameter (inches) 4" x 2" (2) total depth (feet) 630 ft. (3) static water level (feet) Flow below above top of ground. (4) casing 2" galv. 514 ft. (material) (depth) 4" blk - 105 ft. (size) If telescope see back. (5) screen 10 ft, 620 ft. (length) (depth to top) .010 stainless steel (size) (material) (6) pump 3/4 h.p. 19 (HP) (yield gpm) Electric (type power) (7) electric log No (yes or no) (organization running log) (8) how well bottom plugged B.P.V.	Clay	560	600	
	Sand	600	650	
	DRILLERS REMARKS:			


DEPARTMENT OF WATER CONTROL

MAY 18 1976

DEPARTMENT OF WATER CONTROL

If well telescopes please sketch and show depths.

GROUND LEVEL

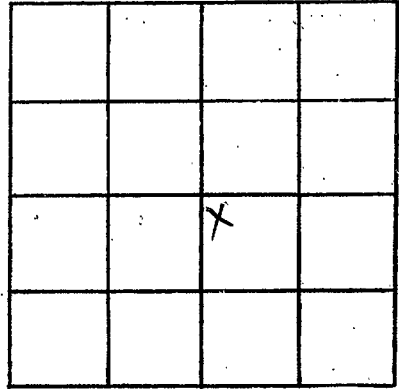

SECTION 18

Please indicate well location X.

ADDITIONAL INFORMATION

If more than one screen,
show locations of each on sketch.