

Leflore
L 62008
7/23/76

MISSISSIPPI
 BOARD OF WATER COMMISSIONERS
 416 North State Street
 Jackson, Mississippi 39201
 WATER WELL DRILLERS LOG


July 23 1976 Bruce Berryman - Greenwood. Leflore
 date well completed firm name county well located

LANDOWNER: Richard Bussey Hwy 82E, Greenwood, Miss.	description of fomations encountered	from	to
(mailing address)	Clay	0	30
WELL LOCATION: sec. 17 T. 19 N. R. 2 E 5 miles E of Greenwood (distance) (direction) (nearest town)	Sand	30	80
WELL PURPOSE: Home (home, irrigation, municipal, industrial)	Sand & Gravel	80	115
WELL COMPLETION DATA:	Clay	115	160
(1) diameter (inches) 4" x 2"	Sand	160	180
(2) total depth (feet) 588 ft.	Sandy Shale	180	220
(3) static water level (feet) 1 ^{below} 100 top of ground.	Sand	220	240
(4) casing 4" galv. = 105 ft. (material) (depth)	Shale	240	320
(size) If telescope see back.	Sand	320	360
(5) screen 20 ft. 568 ft. (length) (depth to top)	Clay	360	370
.010 Stainless steel (size) (material)	Sand	370	380
(6) pump 1 1/2 35 (HP) (yield gpm)	Shale & str. sand	380	435
Electric (type power)	Sand	435	445
(7) electric log No (yes or no)	Clay	445	460
(organization running log)	Clay & sand str.	460	480
(8) how well bottom plugged B.P.V	Clay	480	490
DRILLERS REMARKS:	Sand	490	510
	Shale	510	530
	Sand	530	540
	Clay	540	550
	Fine sand	550	560
	Brown sand	560	570
	Sand	570	590
	Clay	590	600

RECEIVED
 OCT 5 1976
 MISS. BD. OF WATER COMM

If well telescopes please sketch and show depths.

GROUND LEVEL

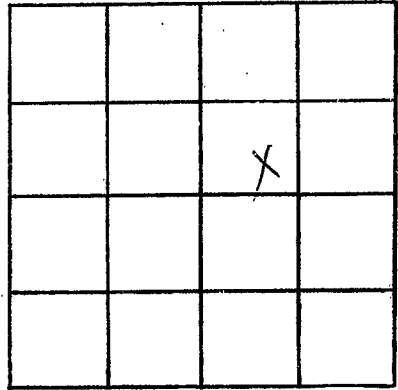

SECTION 17

Please indicate well location X.

ADDITIONAL INFORMATION

If more than one screen,
show locations of each on sketch.