

Leflore
L 9209
8/25/76

MISSISSIPPI
 BOARD OF WATER COMMISSIONERS
 416 North State Street
 Jackson, Mississippi 39201

WATER WELL DRILLERS LOG


August 25 1976 Bruce Berryman Leflore
 date well completed firm name county well located
 Greenwood

LANDOWNER:	description of formations encountered	from	to
Mrs. McCaskill	Clay	0	20
Rt. 1. Greenwood,	Sand	20	100
Miss. 38930.	Clay	100	160
(mailing address)	Shale	160	190
WELL LOCATION:	Sand	190	200
sec. 20 T. 19 N. R. 2 E	Shale	200	280
16 miles SE of Greenwood	Sand	280	305
(distance) (direction) (nearest town)	Shale	305	325
WELL PURPOSE: Home	Sand	325	335
(home, irrigation, municipal, industrial)	Shale	335	370
WELL COMPLETION DATA:	Sand	370	390
(1) diameter (inches) 2"	Clay	390	410
(2) total depth (feet) 388ft			
(3) static water level (feet) flow above top of ground.			
(4) casing galv. 378 ft. (material) (depth)			
(size) If telescope see back.			
(5) screen 10ft 368ft (length) (depth to top)			
.010 stainless steel (size) (material)			
(6) pump 1/2 10 (HP) (yield gpm)			
Electric (type power)			
(7) electric log No (yes or no)			
(organization running log)			
(8) how well bottom plugged B.P.V			
DRILLERS REMARKS:			

NOV 19 1976
 MISS. BD. OF WATER COMMISSIONERS

If well telescopes please sketch and show depths.

GROUND LEVEL

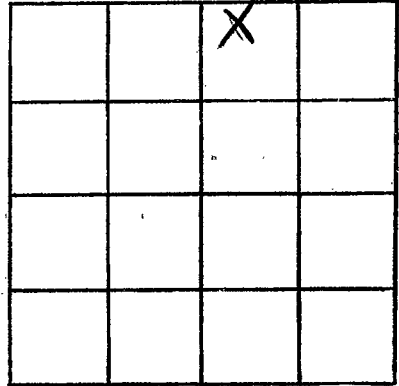

SECTION 20

Please indicate well location X.

ADDITIONAL INFORMATION

If more than one screen,
show locations of each on sketch.