

Leflore
L. Joll
3-10-77

MISSISSIPPI
 BOARD OF WATER COMMISSIONERS
 416 North State Street
 Jackson, Mississippi 39201

WATER WELL DRILLERS LOG

3-10-77

19 BUTANE GAS CO. OF GREENWOOD

Leflore

date well completed

firm name


county well located

LANDOWNER:	description of fomations encountered	from	to
ERBY Welch			
Greenwood (mailing address)	Sand	18	64
WELL LOCATION:	Sand + Pea GRAVEL	64	85
sec. <u>13</u> T. <u>19</u> (N) R. <u>17</u> (E)	Sand + GRAVEL	85	130
<u>1/2</u> miles <u>S</u> of <u>Greenwood</u>	SHALE	130	144
(distance) (direction) (nearest town)	Sand + SHALE	144	210
WELL PURPOSE:	Sand - SHALE + ROCK	210	285
(home, irrigation, municipal, industrial)	Sand	285	304
WELL COMPLETION DATA:	Sand + SHALE	304	380
(1) diameter (inches) <u>4x2</u>	GREEN SAND + ROCK	380	444
(2) total depth (feet) <u>693</u>	SHALE	444	525
(3) static water level (feet) <u>1</u> (below/above top of ground)	GREEN SAND	525	560
(4) casing <u>Steel</u> (material), <u>673</u> (depth)	Sand + SHALE	560	585
<u>4x2</u> (size) if telescope see back.	GREEN SAND	585	625
(5) screen <u>20</u> (length), <u>673</u> (depth to top)	GREEN SAND + SHALE	625	664
<u>2"</u> (size), <u>Stainless</u> (material)	Sand	664	704
(6) pump <u>3/4</u> (HP), <u>15</u> (yield gpm)			
<u>REC</u> (type power)			
(7) electric log <u>NV</u> (yes or no)			
(organization running log)			
(8) how well bottom plugged <u>Back pressure valve</u>			
DRILLERS REMARKS:			

RECEIVED
 MAR 21 1977
 MISS. BB. OF WATER COMMISSIONERS

If well telescopes please sketch and show depths.

GROUND LEVEL

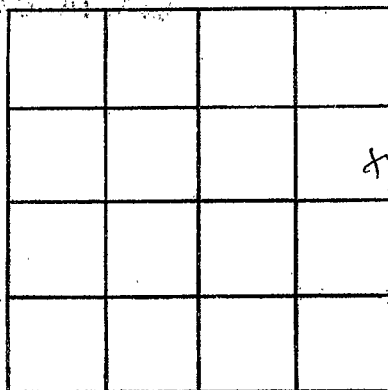

SECTION 23

Please indicate well location X.

ADDITIONAL INFORMATION

If more than one screen,
show locations of each on sketch.