

Leflore  
6 2012  
5-12-77

MISSISSIPPI  
 BOARD OF WATER COMMISSIONERS  
 416 North State Street  
 15J Jackson, Mississippi 39201

WATER WELL DRILLERS LOG

5-12-77 19 BUTANE GAS CO. OF GREENWOOD Leflore  
 date well completed firm name county well located

LANDOWNER:  
GARRETT & SONS INC.  
Greenwood  
 (mailing address)

WELL LOCATION:  
 sec. 21 T. 19N R. 1E  
S W  
1/2 miles S of Greenwood  
 (distance) (direction) (nearest town)

WELL PURPOSE: ind  
 (home, irrigation, municipal, industrial)

WELL COMPLETION DATA:  
 (1) diameter (inches) 4 X  
 (2) total depth (feet) 797  
 (3) static water level (feet) 4 below top of ground.  
 (4) casing Steel, 777,  
 (material) (depth)  
4 X If telescope see back.  
 (size)  
 (5) screen 20', 777  
 (length) (depth to top)  
2" Stainless  
 (size) (material)  
 (6) pump 1, 27  
 (HP) (yield gpm)  
F12C  
 (type power)  
 (7) electric log NO  
 (yes or no)  
 (organization running log)  
 (8) how well bottom plugged Back Pressure Valve

description of formations encountered	from	to
CLAY	0	18
SAND	18	80
SAND & GRAVEL	80	120
CLAY	120	180
SAND	180	260
CLAY	260	320
SAND & SHALE	320	460
SHALE	460	600
CLAY	600	690
SHALE & SAND	690	735
CLAY	735	770
White Sand	770	810

10CH7 74W Pump  
Set on 63' - 1 1/4 PVC

**RECEIVED**

MAY 23 1977

DRILLERS REMARKS:

MISSISSIPPI BOARD OF WATER COMMISSIONERS

If well telescopes please sketch and show depths.

GROUND LEVEL


105' - 4" CASING



672' - 2" CASING



20' - 2" SCREEN

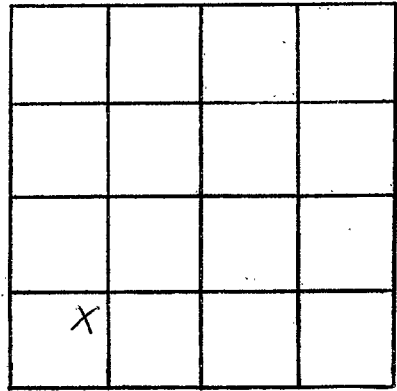

SECTION 21

Please indicate well location X.

ADDITIONAL INFORMATION

If more than one screen, show locations of each on sketch.