

LeFlore
 L 2018
 9/9/77

MISSISSIPPI
 BOARD OF WATER COMMISSIONERS
 416 North State Street
 Jackson, Mississippi 39201

WATER WELL DRILLERS LOG

Sept. 9 19 77 Bruce Berryman Leflore
 date well completed Greenwood, MS county well located

LANDOWNER: M.B. Dyer
 P.O. Box 840
 Greenwood, MS. 38930.
 (mailing address)

WELL LOCATION:
 sec. 25 T. 19 N. R. 1 E
 1 miles SE of Greenwood
 (distance) (direction) (nearest town)

WELL PURPOSE: Home
 (home, irrigation, municipal, industrial)

WELL COMPLETION DATA:
 (1) diameter (inches) 4" x 2"
 (2) total depth (feet) 671'
 (3) static water level (feet) 3' below top of ground
 (4) casing 2" black galv. - 126' (material) (depth)
 (5) screen 20' 651' (length) (depth to top)
 .010 stainless steel (size) (material)
 (6) pump NO (HP) (yield gpm)
 (type power)
 (7) electric log NO (yes or no)
 (organization running log)
 (8) how well bottom plugged B.P.V.

description of fomations encountered	from	to
Clay	0	20
Sand	20	60
Sand & Gravel	60	120
White sand	120	160
Shale	160	240
Green shale	240	260
Green sand	240	300
Sandy shale	300	320
Sand	320	340
Shale	340	420
Sandy shale	420	440
Brown sand & shale	440	460
Shale	460	535
Sand	535	540
Shale	540	550
Sand	550	580
Shale & Str. sand	580	630
Sand	630	640
Shale	640	650
Sand	650	690

RECEIVED


APR - 5 1978

MISS. BD. OF WATER COMM

DRILLERS REMARKS:

If well telescopes please sketch and show depths.

GROUND LEVEL

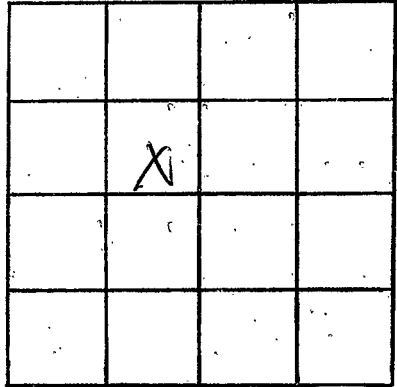

SECTION 25

Please indicate well location X.

ADDITIONAL INFORMATION

Lined area for additional information.

If more than one screen, show locations of each on sketch.