

LEFLORE

L 2073

4-09-79

MISSISSIPPI BOARD OF WATER COMMISSIONERS 416 North State Street Jackson, Mississippi 39201

WATER WELL DRILLERS LOG

BUTANE GAS COMPANY

Leflore

4-9-79 19

date well completed

OF GREENWOOD

county well located

LANDOWNER:	description of formations encountered	from	to
WATER WAIT Greenwood (mailing address)			
WELL LOCATION: sec. 7 T. 19 N S R. 1 E 1 miles W of Greenwood (distance) (direction) (nearest town)	SAND	10	50
WELL PURPOSE: Home (home, irrigation, municipal, industrial)	SAND + Pea GRAVEL	50	70
WELL COMPLETION DATA: (1) diameter (inches) 4 x 2	GRAVEL	70	130
(2) total depth (feet) 870	SAND + GRAVEL	130	155
(3) static water level (feet) _____ <u>below</u> above top of ground.	SAND	155	170
(4) casing <u>Steel</u> 850 (material) (depth)	SAND + CLAY	170	285
<u>4 1/2</u> if telescope see back. (size)	CLAY	285	325
(5) screen <u>20</u> 850 (length) (depth to top)	SLATE + ROCK	325	375
<u>2"</u> <u>Stainless</u> (size) (material)	SAND	375	450
(6) pump <u>1</u> <u>27</u> (HP) (yield gpm)	SLATE + ROCK	450	540
<u>Elec</u> (type power)	SANDY SLATE	540	625
(7) electric log <u>NO</u> (yes or no)	Gummy SLATE	625	710
(organization running log)	SAND + SLATE	710	825
(8) how well bottom plugged <u>PACK PRESSURE VALVE</u>	HARD PACKED SAND	825	874
DRILLERS REMARKS:	SLATE	874	884


Miss. Board of Water Commis

APR 18 1979

RECEIVED

If well telescopes please sketch and show depths.

GROUND LEVEL

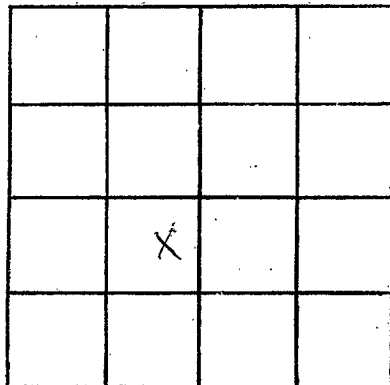

SECTION 1

Please indicate well location X.

ADDITIONAL INFORMATION

If more than one screen, show locations of each on sketch.