

Leflore
L 7024
1-3-80

MISSISSIPPI
BOARD OF WATER COMMISSIONERS
416 North State Street
Jackson, Mississippi 39201

WATER WELL DRILLERS LOG

BUTANE GAS COMPANY
OF GREENWOOD

Leflore
county well located

1-3-80
date well completed

LANDOWNER:

George Winters

description of formations encountered

from to

Greenwood
(mailing address)

<u>Clay</u>	<u>0</u>	<u>18</u>
<u>Sand</u>	<u>18</u>	<u>80</u>
<u>Clay</u>	<u>80</u>	<u>228</u>
<u>SAND</u>	<u>220</u>	<u>408</u>
<u>SAND</u>	<u>400</u>	<u>461</u>

WELL LOCATION:

sec 1 T 19 N R 1 E
1/2 miles NE of Greenwood
(distance) (direction) (nearest town)

WELL PURPOSE: Home
(home, irrigation, municipal, industrial)

WELL COMPLETION DATA:

- (1) diameter (inches) 2"
- (2) total depth (feet) 461
- (3) static water level (feet) 2 below top of ground.
- (4) casing Steel 421
(material) (depth)
2 if telescope see back.
(size)
- (5) screen 20 421
(length) (depth to top)
2 Stainless
(size) (material)
- (6) pump 3/4 10
(HP) (yield gpm)
Elec
(type power)
- (7) electric log NO
(yes or no)

(organization running log)

(8) how well bottom plugged Back Pressure Valve


DRILLERS REMARKS:

DEPT. OF NATURAL RESOURCES
BUREAU OF LAND & WATER RESOURCES

JAN 8 1980
RECEIVED

If well telescopes please sketch and show depths.

GROUND LEVEL

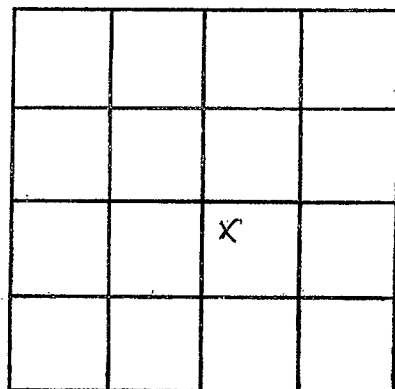

SECTION 1

Please indicate well location X.

ADDITIONAL INFORMATION

If more than one screen,
show locations of each on sketch.