

MISSISSIPPI DEPARTMENT OF NATURAL RESOURCES
Bureau of Land and Water Resources
 Southport Mall
 P.O. Box 10631
 Jackson, Mississippi 39209
WATER WELL DRILLERS LOG

Leflore
L
2026

~~2023~~

12 Mar 82 Copperage Drilling Inc Leflore
 date well completed firm name county well located

LANDOWNER: Steve Burgess
P.O. Box 1636
Greenwood, MS
 (mailing address)

WELL LOCATION:
 sec. 17 19N R. 2E
10 miles East of Greenwood
 (distance) (direction) (nearest town)

WELL PURPOSE:
 (home, irrigation, municipal, industrial)

WELL COMPLETION DATA:

- (1) diameter (inches) 6"
- (2) total depth (feet) 480
- (3) static water level (feet) 190 below top of ground. 4"-300" above
- (4) casing PVC 2"-160'
 (material) (depth)
- 4x2 if telescope see back.
 (size)
- (5) screen 20 460'
 (length) (depth to top)
2" #10 PVC
 (size) (material)
- (6) pump 1HP 19
 (HP) (yield gpm)
230V/1PH
 (type/power)
- (7) electric log No
 (yes or no)
No
 (organization running log)
- (8) how well bottom plugged 2" Brass
Back Wash Valve

description of formations encountered	from	to
Mud	0	20
Sand	20	40
Sand & gravel	40	60
Sand	60	80
Mud	80	200
Hard Shale Rock	200	200 1/2
Fine Sand	200 1/2	220
Sand & Mud	220	250
Rock	250	250 1/2
Mud	250 1/2	400
Sand	400	430
Rock	430	430 3/4
Sand & Mud	430 3/4	480

DRILLERS REMARKS: Pump Set
@ 27' - 18' Stage on 1/4"
Main Pipe


DEPT. OF NATURAL RESOURCES
 BUREAU OF LAND & WATER RESOURCES

MAR - 8 1982

RECEIVED

If well telescopes please sketch and show depths.

GROUND LEVEL

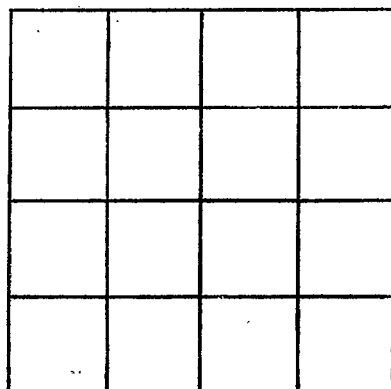

SECTION _____

Please indicate well location X.

ADDITIONAL INFORMATION

If more than one screen, show locations of each on sketch.