

MISSISSIPPI DEPARTMENT OF NATURAL RESOURCES

Bureau of Land and Water Resources

Southport Mall

P.O. Box 10631

Jackson, Mississippi 39209

WATER WELL DRILLERS LOG
BUTANE GAS COMPANY

DE GREENWOOD
firm name

Leflore
L 2027

Sept 10 19 *82*
date well completed

Leflore
county well located

LANDOWNER:
Dick Johnson

(mailing address)

WELL LOCATION:
sec. *20* T *14* N R. *20* E
3.5 miles *S.E.* of *Lumberton*
(distance) (direction) (nearest town)

WELL PURPOSE: *domestic*
(home, irrigation, municipal, industrial)

- WELL COMPLETION DATA:
- (1) diameter (inches) *4"*
 - (2) total depth (feet) *230*
 - (3) static water level (feet) *0* ^{below} ~~above~~ top of ground.
 - (4) casing *PVC*, *210*,
(material) (depth)
4"
(size) If telescope see back.
 - (5) screen *20'*, *210*
(length) (depth to top)
4", *PVC*.
(size) (material)
 - (6) pump *1/2*, *150*
(HP) (yield gpm)
Elect
(type power)
 - (7) electric log *NO*
(yes or no)
No
(organization running log)
 - (8) how well bottom plugged
Rich wood Valve

description of formations encountered	from	to
CLAY	0	30
SAND	30	70
SAND PEbbles	70	145
HARD CLAY	115	165
SAND ROCKST.	165	180
CLAY SAND	180	210
GREEN SAND	210	233
ROCK	233	235
SAND ROCK SHALEST	235	243

DEPT. OF NATURAL RESOURCES
BUREAU OF LAND & WATER RESOURCES


SEP 20 1982

RECEIVED

DRILLERS REMARKS:
Richard Vest

If well telescopes please sketch and show depths.

GROUND LEVEL

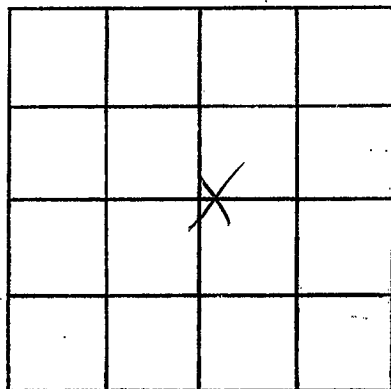

SECTION 20

Please indicate well location X.

ADDITIONAL INFORMATION

If more than one screen,
show locations of each on sketch.