

MISSISSIPPI DEPARTMENT OF NATURAL RESOURCES

Bureau of Land and Water Resources

Southport Mall

P.O. Box 10631

Jackson, Mississippi 39209

WATER WELL DRILLERS LOG

BUTANE GAS COMPANY

Leflore  
L 2098

12-28 1982  
date well completed

OF GREENWOOD  
with name

Leflore  
county well located

LANDOWNER:	description of formations encountered	from	to
<u>Vennis Upchurch</u>	<u>Clay</u>	<u>0</u>	<u>15</u>
(mailing address)	<u>sand</u>	<u>15</u>	<u>80</u>
WELL LOCATION:	<u>gravel</u>	<u>50</u>	<u>120</u>
sec. <u>13</u> T. <u>19</u> (N) R. <u>1</u> (E)	<u>Clay</u>	<u>120</u>	<u>170</u>
<u>4.5</u> miles <u>S.W.</u> of <u>Greenwood</u>	<u>sand &amp; Clay Str.</u>	<u>170</u>	<u>205</u>
(distance) (direction) (nearest town)	<u>cone</u>	<u>205</u>	<u>250</u>
WELL PURPOSE:	<u>Clay &amp; Sand str.</u>	<u>250</u>	<u>305</u>
(home, irrigation, municipal, industrial)	<u>gumming shale</u>	<u>305</u>	<u>353</u>
WELL COMPLETION DATA:	<u>l. shale &amp; rock str.</u>	<u>353</u>	<u>370</u>
(1) diameter (inches) <u>4x2"</u>	<u>sand</u>	<u>370</u>	<u>385</u>
(2) total depth (feet) <u>463</u>	<u>Shale</u>	<u>385</u>	<u>390</u>
(3) static water level (feet) <u>18</u> <sup>(below)</sup> top of ground.	<u>fine sand</u>	<u>390</u>	<u>405</u>
(4) casing <u>steel</u> , <u>325'</u> , <u>CL</u>	<u>sand</u>	<u>405</u>	<u>452</u>
(material) (depth)	<u>Sand &amp; shale str.</u>	<u>452</u>	<u>463</u>
<u>2"</u> If telescope see back.			
(5) screen <u>20'</u> , <u>430</u>			
(length) (depth to top)			
<u>2"</u> , <u>stumpen steel</u>			
(size) (material)			
(6) pump <u>1</u> , <u>10</u>			
(HP) (yield gpm)			
<u>elect.</u>			
(type power)			
(7) electric log <u>No</u>			
(yes or no)			
<u>No</u>			
(organization running log)			
(8) how well bottom plugged			
<u>Back prod. Valve</u>			
DRILLERS REMARKS:			
<u>Richard West Str.</u>			


DEPT. OF NATURAL RESOURCES  
BUREAU OF LAND & WATER RESOURCES

JAN 17 1983


RECEIVED

If well telescopes please sketch and show depths.

GROUND LEVEL

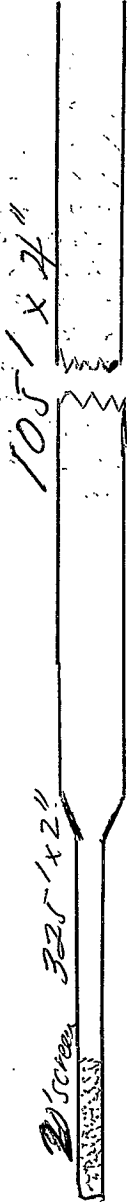

If more than one screen, show locations of each on sketch.

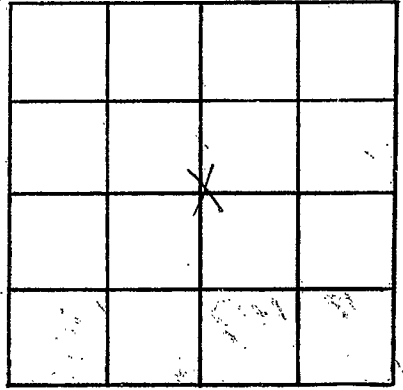

SECTION 13

Please indicate well location X.

ADDITIONAL INFORMATION

Lined area for additional information.