

**MISSISSIPPI DEPARTMENT OF NATURAL RESOURCES**  
**Bureau of Land and Water Resources**  
 Southport Mall  
 P.O. Box 10631  
 Jackson, Mississippi 39209  
**WATER WELL DRILLERS LOG**

Leflore  
L 2089

March 22 1982 Bruce Berryman - Leflore  
 date well completed firm name county well located  
Greenwood.

LANDOWNER: Richard Bussey  
 Rt. 1. Box 219  
 Greenwood. MS 38930  
 (mailing address)

description of formations encountered	from	to
Clay	0	50
Sand	50	60
Shale	60	130
Sand	130	180
Rocks	180	200
Sand	200	250

WELL LOCATION:  
 sec. 17 T. 19 (N) R. 2 (E)  
5 miles E of Greenwood  
 (distance) (direction) (nearest town)

WELL PURPOSE: Home  
 (home, irrigation, municipal, industrial)

**WELL COMPLETION DATA:**

- (1) diameter (inches) 4"
- (2) total depth (feet) 250 ft.
- (3) static water level (feet) 4' below top of ground.
- (4) casing 4" P.V.C. 230'  
 (material) (depth)  
         if telescope see back.  
 (size)
- (5) screen 20' 230'  
 (length) (depth to top)  
4" P.V.C. x .010  
 (size) (material)
- (6) pump No pump set.  
 (HP) (yield gpm)  
          
 (type power)
- (7) electric log NO  
 (yes or no)  
          
 (organization running log)
- (8) how well bottom plugged PVC Cap

DEPT. OF NATURAL RESOURCES  
 BUREAU OF LAND & WATER RESOURCES


FEB -7 1982

**RECEIVED**

DRILLERS REMARKS:

If well telescopes please sketch and show depths.

GROUND LEVEL

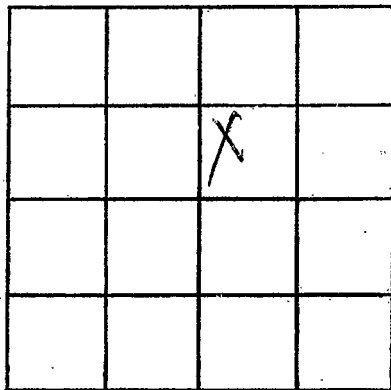

SECTION 17

Please indicate well location X.

ADDITIONAL INFORMATION

If more than one screen,  
show locations of each on sketch.