

MISSISSIPPI DEPARTMENT OF NATURAL RESOURCES
Bureau of Land and Water Resources
 Southport Mall
 P.O. Box 10631
 Jackson, Mississippi 39209
WATER WELL DRILLERS LOG

Leflore
L 2030
2/8/83

Feb. 8 19 83 Bruce Berryman - Leflore
 date well completed firm name county well located
Greenwood

LANDOWNER: F.S.A. Inc.
P.O. Box 1319
Greenwood. MS 38930
 (mailing address)

description of formations encountered	from	to
Clay	0	40
Sand	40	80
Sand & Gravel	80	110

WELL LOCATION:
 sec. 39 T. 19 N. R. 1 E.
5 miles S of G^Wood
 (distance) (direction) (nearest town)

WELL PURPOSE: Industry
 (home, irrigation, municipal, industrial)

WELL COMPLETION DATA:
 (1) diameter (inches) 4"
 (2) total depth (feet) 110 ft.
 (3) static water level (feet) 15' ^{below} ~~above~~ top of ground.
 (4) casing 4" P.V.C., 90'
 (material) (depth)
 if telescope see back.
 (size)
 (5) screen 20', 90'
 (length) (depth to top)
4" P.V.C. .010 gauge
 (size) (material)
 (6) pump 1 h.p. 20
 (HP) (yield gpm)
Electric
 (type power)
 (7) electric log NO
 (yes or no)

 (organization running log)

(8) how well bottom plugged B.P.V.

DRILLERS REMARKS:


DEPT. OF NATURAL RESOURCES
 BUREAU OF LAND & WATER RESOURCES

MAY 12 1983

RECEIVED

If well telescopes please sketch and show depths.

GROUND LEVEL

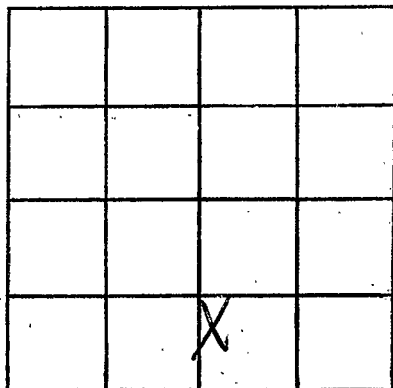

SECTION 32

Please indicate well location X.

ADDITIONAL INFORMATION

If more than one screen,
show locations of each on sketch.