

LEFLORE
L 2072

MISSISSIPPI DEPARTMENT OF NATURAL RESOURCES
Bureau of Land and Water Resources
Southport Mall
P.O. Box 10631
Jackson, Mississippi 39209
WATER WELL DRILLERS LOG

April 16 19 84 Bruce Berryman Leflore
date well completed firm name county well located
Greenwood, MS

LANDOWNER:	description of formations encountered	from	to
Mr. B.I. Minyar	Clay	0	20
516 Naples Rd.	Sand	20	60
Jackson, MS 39200	Sand & Gravel	60	160
(mailing address)	Sandy shale	160	220
WELL LOCATION:	Rock & shale	220	260
sec. <u>31</u> T. <u>19</u> N. R. <u>1</u> E. W.	Sand	260	320
<u>3</u> miles S.E. of <u>Greenwood</u>	Shale	320	370
(distance) (direction) (nearest town)	Fine sand	370	400
WELL PURPOSE: Home	Sandy shale	400	460
(home, irrigation, municipal, industrial)	Hard rock at 415'		
WELL COMPLETION DATA:	Shale	460	480
(1) diameter (inches) <u>4" x 2"</u>	Sandy shale	480	540
(2) total depth (feet) <u>682 feet.</u>	Sandy shale & rock	540	560
(3) static water level (feet) <u>10</u> below top of ground.	Sand	560	600
<u>4" blk.</u> - <u>126'</u>	Sandy shale	600	660
(4) casing <u>2" galv.</u> - <u>536'</u>	Sand	660	700
(material) (depth)			
<u> </u> if telescope see back.			
(size)			
(5) screen <u>20'</u> <u>662'</u>			
(length) (depth to top)			
<u>2" .010 ga. Stainless steel</u>			
(size) (material)			
(6) pump <u>1 h.p.</u> <u>10</u>			
(HP) (yield gpm)			
<u>Electric</u>			
(type power)			
(7) electric log <u>NO.</u>			
(yes or no)			
<u> </u>			
(organization running log)			
(8) how well bottom plugged <u>B.P.V.</u>			

DRILLERS REMARKS:


DEPT. OF NATURAL RESOURCES
BUREAU OF LAND & WATER RESOURCES

JUL 31 1984

RECEIVED

If well telescopes please sketch and show depths.

GROUND LEVEL

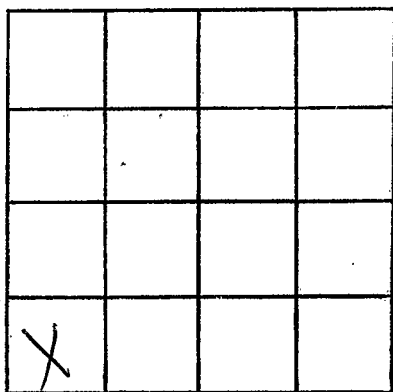

SECTION 31

Please indicate well location X.

ADDITIONAL INFORMATION

If more than one screen,
show locations of each on sketch.