

MISSISSIPPI DEPARTMENT OF NATURAL RESOURCES

Bureau of Land and Water Resources

Southport Mall

P.O. Box 10631

Jackson, Mississippi 39209

WATER WELL DRILLERS LOG

BUTANE GAS COMPANY

LeFlore
L 9033
5/25/85

5-25
date well completed

1985

OF GREENWOOD

LeFlore
Southport
county well located

LANDOWNER:	description of formations encountered	from	to
<u>HARRY O'NEAL</u>	<u>CLAY</u>	<u>0</u>	<u>25</u>
(mailing address)	<u>fine sand</u>	<u>25</u>	<u>65</u>
	<u>sand pea gravel</u>	<u>65</u>	<u>85</u>
	<u>gravel</u>	<u>85</u>	<u>103</u>
<p>WELL LOCATION:</p> <p>sec. <u>8</u> T. <u>14</u> N. R. <u>10</u> E S. W.</p> <p><u>City of Greenwood</u></p> <p>(distance) miles (direction) of (nearest town)</p>			
<p>WELL PURPOSE:</p> <p>(home, irrigation, municipal, industrial)</p>			
<p>WELL COMPLETION DATA:</p>			
(1) diameter (inches) <u>4"</u>			
(2) total depth (feet) <u>103'</u>			
(3) static water level (feet) <u>19</u> ^{below} above top of ground.			
(4) casing <u>PVC</u> , <u>83'</u> (material) (depth)			
<u>4"</u> if telescope see back. (size)			
(5) screen <u>30'</u> , <u>83'</u> (length) (depth to top)			
<u>4"</u> , <u>PVC</u> (size) (material)			
(6) pump <u>1</u> , <u>30</u> (HP) (yield gpm)			
<u>Elect</u> (type power)			
(7) electric log <u>No</u> (yes or no)			
<u>No</u> (organization running log)			
(8) how well bottom plugged <u>Back</u> <u>and 5" plate valve</u>			
<p>DRILLERS REMARKS:</p> <p><u>R. Vent</u></p>			


RECEIVED

JUN -4 1985

Department of Natural Resources
Bureau of Land & Water Resources

If well telescopes please sketch and show depths.

GROUND LEVEL

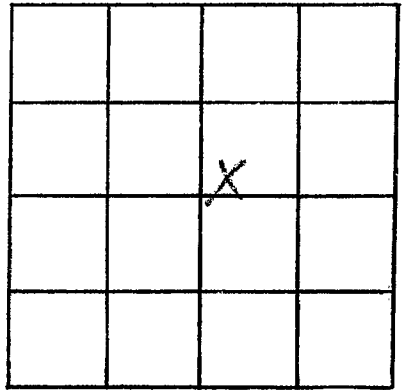

SECTION

Please indicate well location X.

ADDITIONAL INFORMATION

If more than one screen,
show locations of each on sketch.