

MISSISSIPPI DEPARTMENT OF NATURAL RESOURCES

Bureau of Land and Water Resources

P.O. Box 10631

Jackson, Mississippi 39209

WATER WELL DRILLERS LOG

COUNTY WELL LOCATED LEFLORE	
WELL NUMBER 9	CODED
L 7043	
DATE WELL COMPLETED 6-26-87	

PERMIT NUMBER
NAME OF DRILLING FIRM KELEY CONTRACT DEWATERING

NAME & MAILING ADDRESS OF LANDOWNER STATE OF MISSISSIPPI			
WELL LOCATION: SEC TOWNSHIP RANGE			
<u>7</u>	<u>19</u>	<u>N</u>	<u>1</u>
		S	E
		W	W
DISTANCE DIRECTION NEAREST TOWN			
<u>1/2</u> Miles		<u>WEST</u> of <u>GREENWOOD</u>	
OTHER LANDMARK			
WELL PURPOSE: Home, Irrigation, Municipal, Industrial, Fish Pond, etc. DEWATERING			

PUMP DATA		
PUMP TYPE (Circle One): Submersible, <u>Turbine</u> , Jet Flowing Well, Other (Describe) _____		
POWER TYPE (Circle One): <u>Electric</u> , Tractor, Diesel, Gasoline, Butane, Other (Describe) _____		
Pump Capacity (GPM)	No. of Stages	Setting Depth
<u>1000</u>	<u>2</u>	<u>100</u> FT.
PUMP TEST		
Well yielded <u>1000</u> GPM with a drawdown of <u>15</u> ft. after <u>4</u> hours of pumping		

WELL DATA		
Well Depth 126	Casing Diameter (In.) 12"	Casing Length (Ft.) 8628+
Type of Casing STEEL	Hole Depth 130	Depth to Static Water Level -23
TYPE OF COMPLETION: (Circle One or More): <u>Gravel Packed</u> , Underreamed, Telescoped, Natural Development, Open Hole, Other (Describe) _____		
Top of Lap Pipe or Reduction in Casing		
FEET		IF TELESCOPED OR MORE THAN ONE SCREEN: USE BACK PAGE

LOG DATA	
TYPE OF LOG RUN (Circle One): No Log Run, Electric, Gamma Ray, Density, Sonic, Neutron, Other (Describe) _____	
Name of Organization Running Log	

SCREEN DATA		
Diameter - Inches 12"	Length - Feet 40'	Slot Size - Inches .060
Screen Type DOERR METAL		Depth to Bottom - Feet 126

GEOLOGIC DATA (Office Use Only)			
Surface Elev.	Geologic Unit	Unit Thickness	Depth to Top
Subs. SWL	Date	Analysis	Aquifer Test
Driller's Remarks			

DESCRIPTION OF FORMATIONS ENCOUNTERED	FROM	TO	FORMATIONS (Continued)	
			FROM	TO
CLAY	0	30	F SAND & CLAY LENS	115
F SAND, TR SM GRUL ORGANK	30	35	M-CS SAND	120
F SAND, TR SM GRUL	35	38	M WHITE SAND	126
F SAND	38	66		
F-M SAND, SM GRUL	66	72		
CS-M SAND, SM GRUL	72	78		
F SAND	78	86		
M-CS SAND, SM GRUL	86	90		
F-M SAND	90	105		
MED-CS SAND, LG GRUL	105	115		
IF MORE SPACE IS NEEDED, USE BACK				


PUMPED

DEC 28 1988

Department of Natural Resources
Bureau of Land & Water Resources

If well telescopes please
sketch and show depths.

GROUND LEVEL

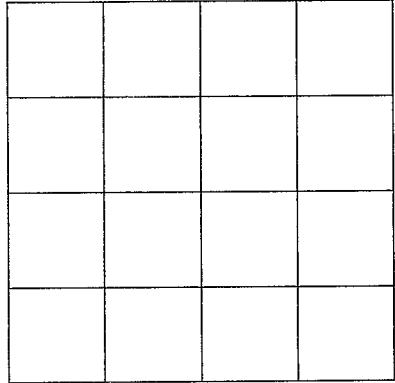

SECTION _____

Please indicate well location X.

ADDITIONAL INFORMATION

If more than one screen,
show location of each on sketch.