

**MISSISSIPPI DEPARTMENT OF ENVIRONMENTAL QUALITY**  
Bureau of Land and Water Resources

P. O. Box 10631  
Jackson, MS 39289-0631  
**WATER WELL DRILLERS LOG**

COUNTY WELL LOCATED <u>LeFlore</u>	
WELL NUMBER <u>L-9058</u>	CODED
DATE WELL COMPLETED <u>10-22-92</u>	

PERMIT NUMBER
NAME OF DRILLING FIRM <u>CES</u>

NAME & MAILING ADDRESS OF LANDOWNER <u>BABA Price</u>		
<u>Granda Blm EXT.</u>		
<u>freewood, ms</u>		
WELL LOCATION: SEC	TOWNSHIP	RANGE
<u>1</u>	<u>12</u>	<u>719 N R1 E</u>
DISTANCE	DIRECTION	NEAREST TOWN
<u>1</u> Miles	<u>NE</u> of	<u>Greenwood</u>
OTHER LANDMARK		
WELL PURPOSE <input checked="" type="checkbox"/> Home, Irrigation, Municipal, Industrial, Fish Pond, etc.		

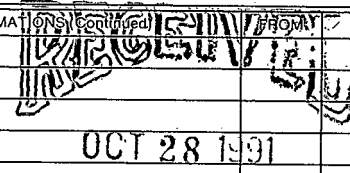
<b>PUMP DATA</b>		
PUMP TYPE (Circle One): <input checked="" type="checkbox"/> Submersible, Turbine, Jet, Flowing Well, Other (Describe) _____		
POWER TYPE (Circle One): <input checked="" type="checkbox"/> Electric, Tractor, Diesel, Gasoline, Butane, Other (Describe) _____ H/P _____		
Pump Capacity (GPM) <u>20</u>	No. of Stages <u>7</u>	Setting Depth <u>42</u> FT.
PUMP TEST		
Well yielded <u>20</u> GPM with a drawdown of <u>22</u> ft. after <u>12</u> hours of pumping		

<b>WELL DATA</b>		
Well Depth <u>410</u>	Casing Diameter (In.) <u>4" X 9"</u>	Casing Length (Ft.) <u>390</u>
Type of Casing <u>Steel</u>	Hole Depth <u>405</u>	Depth to Static Water Level <u>3</u>
TYPE OF COMPLETION: (Circle One or More): <input checked="" type="checkbox"/> Gravel Packed, Underreamed, Telescoped, <input checked="" type="checkbox"/> Natural Development, Open Hole, Other (Describe) _____		
Top of Lap Pipe or Reduction in Casing		
FEET <input type="checkbox"/> IF TELESCOPED OR MORE THAN ONE SCREEN: USE BACK PAGE		

<b>LOG DATA</b>	
TYPE OF LOG RUN (Circle One): No Log Run, Electric, Gamma Ray, Density, Sonic, Neutron, Other (Describe) _____	
Name of Organization Running Log	

<b>SCREEN DATA</b>		
Diameter - Inches <u>2</u>	Length - Feet <u>20</u>	Slot Size - Inches <u>.010</u>
Screen Type <u>Stainless Steel</u>	Depth to Bottom - Feet <u>410</u>	

<b>GEOLOGIC DATA (Office Use Only)</b>			
Surface Elev.	Geologic Unit	Unit Thickness	Depth to Top
Subs. SWL	Date	Analysis	Aquifer Test
Driller's Remarks			

DESCRIPTION OF FORMATIONS ENCOUNTERED	FROM	TO	FORMATIONS (Continued)	FROM	TO
TOP SOIL & CLAY	0	22			
SAND	22	46			
SAND & GRAVEL	46	128			
CLAY	128	216			
SANDY SHELL	216	286			
ROCK	286	289			
SHELL	289	371			
ROCK	371	372			
SAND	372	410			

IF MORE SPACE IS NEEDED, USE BACK

If well telescopes please  
sketch and show depths.

GROUND LEVEL

	X		

SECTION 12

Please indicate well location X.

ADDITIONAL INFORMATION

If more than one screen,  
show location of each on sketch.