

**MISSISSIPPI DEPARTMENT OF ENVIRONMENTAL
QUALITY**

Office of Land and Water Resources

COUNTY WELL LOCATED LeFlore	
WELL NUMBER 2061	CODED
DATE WELL COMPLETED 7-1-94	

PERMIT NUMBER

NAME OF DRILLING FIRM
IRRIGATION EQUIPMENT

601/887-2555

INDIANOLA, MS

P. O. Box 10631
Jackson, MS 39289-0631
WATER WELL DRILLERS LOG

NAME & MAILING ADDRESS OF LANDOWNER FLAUNT ESTATE FARM		
Rt. 1, Box 177		
Sidon, MS 38954		
WELL LOCATION:	SEC	TOWNSHIP RANGE
SE/NW	35	19 N 1 E
DISTANCE	DIRECTION	NEAREST TOWN
3 Miles	EAST	of Rising Sun
OTHER LANDMARK		
WELL PURPOSE: Home, Irrigation, Municipal, Industrial, Fish Pond, etc. Irrigation		

WELL DATA

Well Depth 107	Casing Diameter (In.) 1 1/2	Casing Length (Ft.) 67
Type of Casing Steel	Hole Depth 107	Depth to Static Water Level 12'
TYPE OF COMPLETION: (Circle One or More): <input checked="" type="checkbox"/> Gravel Packed, <input type="checkbox"/> Underreamed, <input type="checkbox"/> Telescoped, <input type="checkbox"/> Natural Development, <input type="checkbox"/> Open Hole, <input type="checkbox"/> Other (Describe)		

WELL GROUTED TO A DEPTH OF _____ FEET
Type Grout (circle one): Cement, Bentonite, or Mix

SCREEN DATA

Diameter - Inches 1 1/2	Length - Feet 40	Slot Size - Inches .060
Screen Type Steel	Depth to Bottom - Feet 107	

PUMP DATA

PUMP TYPE (Circle One):
Submersible, Turbine, Jet Flowing Well,
Other (Describe) _____
POWER TYPE (Circle One):
Electric, Tractor, Diesel, Gasoline, Butane,
Other (Describe) _____ H/P 60

Pump Capacity (GPM) 3000	No. of Stages 1	Setting Depth 60 FT.
------------------------------------	---------------------------	--------------------------------

PUMP TEST

Well yielded _____ GPM with
a drawdown of _____ ft.
after _____ hours of pumping

LOG DATA

TYPE OF LOG RUN (Circle One): No Log Run,
Electric, Gamma Ray, Density, Sonic, Neutron,
Other (Describe) _____

Name of Organization Running Log

GEOLOGIC DATA (Office Use Only)

Surface Elev.	Geologic Unit	Unit Thickness	Depth to Top
Subs. SWL	Date	Analysis	Aquifer Test

Driller's Remarks

Top of Lap Pipe or Reduction in Casing

FEET IF TELESKOPED OR MORE THAN ONE SCREEN: USE BACK PAGE

DESCRIPTION OF FORMATIONS ENCOUNTERED	FROM	TO
clay	0	15
Fine sand	15	35
Fine sand + Gravel	35	55
Fine sand	55	65
Fine sand + Gravel	65	75
medium sand + Gravel	75	95
coarse sand + Gravel	95	107

FORMATIONS (Continued)

FROM

TO

RECEIVED


SEP 06 1994

Dept. of Environmental Quality
Office of Land & Water Resources

IF MORE SPACE IS NEEDED, USE BACK

If well telescopes please
sketch and show depths.

GROUND LEVEL

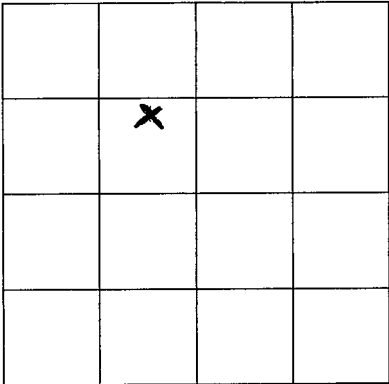

SECTION 35

Please indicate well location X.

ADDITIONAL INFORMATION

If more than one screen,
show location of each on sketch.