

Leflore
L 2014
11-19-76

MISSISSIPPI
 BOARD OF WATER COMMISSIONERS
 416 North State Street
 Jackson, Mississippi 39201

WATER WELL DRILLERS LOG

11-19-76 ¹⁵⁵ BUTANE GAS CO. OF GREENWOOD Leflore
 date well completed firm name county well located

LANDOWNER:
Kenneth Mims
Greenwood
 (mailing address)

WELL LOCATION:
 sec. 13 T. 19 N. R. 4E
1 miles E of Greenwood
 (distance) (direction) (nearest town)

WELL PURPOSE:
Ind.
 (home, irrigation, municipal, industrial)

WELL COMPLETION DATA:

(1) diameter (inches) 4x2

(2) total depth (feet) 645

(3) static water level (feet) 2 ^{below} _{above} top of ground.

(4) casing Steel 625
 (material) (depth)

4x2 If telescope see back.
 (size)

(5) screen 20' 6x5
 (length) (depth to top)

2" Stainless
 (size) (material)

(6) pump 1 20
 (HP) (yield gpm)

Elec.
 (type power)

(7) electric log No
 (yes or no)

(organization running log)

description of formations encountered	from	to
Clay	0	40
SAND	40	64
SAND + Pea Gravel	64	144
White Clay	144	185
Brown Shale	185	205
Shale + Rock	205	207
SAND - Shale - Rock	207	244
SAND	244	264
SAND + Shale	264	324
Brown Shale	324	344
Sand	344	360
Shale + Rock	360	390
SAND + Rock	390	424
Shale	424	504
SAND + Shale	504	544
Sand	544	580
Shale	580	620
SAND	620	648

RECEIVED

NOV 29 1976

DRILLERS REMARKS:

MISS. BD. OF WATER COMM.

(8) how well bottom plugged:
Back Pressure Valve


If well telescopes please sketch and show depths.

GROUND LEVEL

105' - 4" CASING →

520' - 2" CASING →

20' - 2" SCREEN →

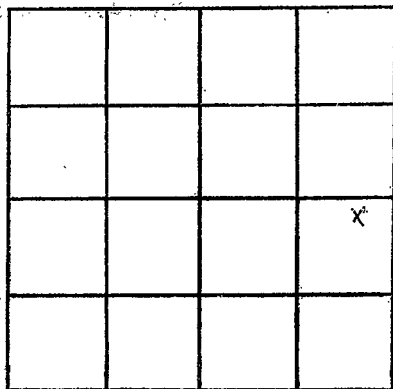

SECTION 13

Please indicate well location X.

ADDITIONAL INFORMATION

If more than one screen, show locations of each on sketch.