

## Office of Land and Water Resources

P. O. Box 10631

Jackson, MS 39289-0631

WATER WELL DRILLERS LOG

COUNTY WELL LOCATED <i>Leflore</i>		MISSISSIPPI	
WELL NUMBER <i>1</i>	CODING	PERMIT NUMBER	
<i>L 2065</i>		NAME OF DRILLING FIRM <i>CBS Drilling</i>	
DATE WELL COMPLETED <i>11-96</i>			

NAME & MAILING ADDRESS OF LANDOWNER

James Kendall

Hy. 7 North

Greenwood, ms 38930

WELL LOCATION: SEC TOWNSHIP RANGE

1 T19 N R2 E

W

DISTANCE DIRECTION NEAREST TOWN

2 N of Greenwood

Miles

OTHER LANDMARK

WELL PURPOSE (Home, Irrigation, Municipal, Industrial, Fish Pond, etc.)

PUMP DATA			
PUMP TYPE (Circle One):			
Submersible,	Turbine,	Jet	Flowing Well,
Other (Describe) _____			
POWER TYPE (Circle One):			
Electric	Tractor,	Diesel,	Gasoline, Butane,
Other (Describe) _____		H/P _____	
Pump Capacity (GPM)	No. of Stages	Setting Depth	
20	9	63 FT.	
PUMP TEST			
Well yielded 20 GPM with			
a drawdown of _____ ft.			
after _____ hours of pumping			

## LOG DATA

Well Depth 550	Casing Diameter (In.) 4	Casing Length (Ft.) 530
Type of Casing PVC	Hole Depth 565	Depth to Static Water Level 3
TYPE OF COMPLETION: (Circle One or More):		
Gravel Packed,	Underreamed,	Telescoped,
Natural Development,	Open Hole,	Other
(Describe) _____		

TYPE OF LOG RUN (Circle One): No Log Run  
Electric, Gamma Ray, Density, Sonic, Neutron,  
Other (Describe) \_\_\_\_\_

Name of Organization Running Log \_\_\_\_\_

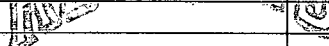

## GEOLOGIC DATA (Office Use Only)

Surface Elev.	Geologic Unit	Unit Thickness	Depth to Top
Subs. SWL	Date	Analysis	Aquifer Test

## SCREEN DATA

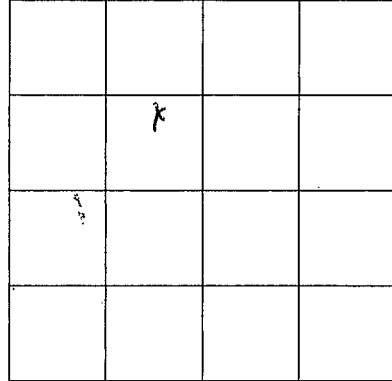
Diameter - Inches 4	Length - Feet 20	Slot Size - Inches P4.010
Screen Type PVC		Depth to Bottom - Feet 550

Driller's Remarks

DESCRIPTION OF FORMATIONS ENCOUNTERED	FROM	TO	FORMATIONS (Continued):	FROM	TO
TOP SOIL	0	19			
SAND	19	42			
SAND & GRAVEL	42	146	<div style="text-align: center;"> <p>FEB 05 1996</p> <p>Dept. of Environmental Quality Office of Land &amp; Water Resources</p> </div>		
CLAY & ROCKS	146	242			
SAND	242	290			
SHELL & ROCKS	290	515			
SAND	515	558			
CLAY	558	565			
			IF MORE SPACE IS NEEDED, USE BACK		

If well telescopes please  
sketch and show depths.

GROUND LEVEL



SECTION 1

Please indicate well location X.

ADDITIONAL INFORMATION

If more than one screen,  
show location of each on sketch.