

**MISSISSIPPI DEPARTMENT OF ENVIRONMENTAL QUALITY**

Office of Land and Water Resources

P. O. Box 10631  
Jackson, MS 39289-0631  
**WATER WELL DRILLERS LOG**

COUNTY WELL LOCATED <b>LeFlore</b>	
WELL NUMBER <b>L 7067</b>	CODED
DATE WELL COMPLETED <b>12-2-98</b>	

PERMIT NUMBER
NAME OF DRILLING FIRM <b>IRRIGATION EQUIPMENT</b>
<b>601/887-2555</b>
<b>INDIANOLA, MS</b>

NAME & MAILING ADDRESS OF LANDOWNER <b>Supreme INC.</b>		
<b>P.O. Box 663</b>		
<b>Greenwood, MS 38935</b>		
WELL LOCATION:	SEC	TOWNSHIP
<b>SE/SE</b>	<b>23</b>	<b>19</b>
		RANGE
		<b>1</b>
DISTANCE	DIRECTION	NEAREST TOWN
<b>2</b> Miles	<b>South</b>	<b>Greenwood</b>
OTHER LANDMARK		
WELL PURPOSE: Home, Irrigation, Municipal, Industrial, Fish Pond, etc. <b>Irrigation Pivot</b>		

<b>PUMP DATA</b>		
PUMP TYPE (Circle One): Submersible, <b>Turbine</b> Jet Flowing Well, Other (Describe)		
POWER TYPE (Circle One): Electric, Tractor, <b>Diesel</b> Gasoline, Butane, Other (Describe) H/P <b>80</b>		
Pump Capacity (GPM) <b>1400</b>	No. of Stages <b>3</b>	Setting Depth <b>50</b> FT.
PUMP TEST		
Well yielded _____ GPM with a drawdown of _____ ft. after _____ hours of pumping		

<b>WELL DATA</b>		
Well Depth <b>116</b>	Casing Diameter (In.) <b>12</b>	Casing Length (Ft.) <b>76</b>
Type of Casing <b>Steel</b>	Hole Depth <b>116</b>	Depth to Static Water Level

<b>LOG DATA</b>	
TYPE OF LOG RUN (Circle One): Electric, Gamma Ray, Density, Sonic, Neutron, Other (Describe) _____ No Log Run	
Name of Organization Running Log	


TYPE OF COMPLETION: (Circle One or More): <b>Gravel Packed</b> , Underreamed, Telescoped, Natural Development, Open Hole, Other (Describe)			
WELL GROUTED TO A DEPTH OF _____ FEET Type Grout (circle one): Cement, Bentonite, or Mix			

<b>GEOLOGIC DATA (Office Use Only)</b>			
Surface Elev.	Geologic Unit	Unit Thickness	Depth to Top
Subs. SWL	Date	Analysis	Aquifer Test

<b>SCREEN DATA</b>		
Diameter - Inches <b>12</b>	Length - Feet <b>40</b>	Slot Size - Inches <b>0.060</b>
Screen Type <b>Steel</b>	Depth to Bottom - Feet <b>116</b>	

Driller's Remarks <b>Big-D Greenwood, MS</b>
Top of Lap Pipe or Reduction in Casing <b>FEET</b> IF TELESCOPED OR MORE THAN ONE SCREEN: USE BACK PAGE

DESCRIPTION OF FORMATIONS ENCOUNTERED	FROM	TO
<b>Clay</b>	<b>0</b>	<b>28</b>
<b>Fine SAND</b>	<b>28</b>	<b>40</b>
<b>Fine SAND + Gravel</b>	<b>40</b>	<b>50</b>
<b>med. SAND + Gravel</b>	<b>50</b>	<b>68</b>
<b>Fine SAND</b>	<b>68</b>	<b>71</b>
<b>med. SAND + Gravel</b>	<b>71</b>	<b>116</b>

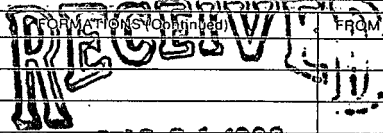

**DEC 21 1998**

Dept. of Environmental Quality  
Office of Land & Water Resources

IF MORE SPACE IS NEEDED, USE BACK

If well telescopes please sketch and show depths.

GROUND LEVEL

			X

SECTION 23

Please indicate well location X.

ADDITIONAL INFORMATION

If more than one screen,  
show location of each on sketch.