

LEFLORE
M
5-11-73

MISSISSIPPI
BOARD OF WATER COMMISSIONERS
416 North State Street
Jackson, Mississippi 39201

CODED

WATER WELL DRILLERS LOG

5-11 19 73 date well completed
DYER WELL & IRRIGATION SERVICE LEFLORE firm name
county well located

LANDOWNER: Bobby Dorton
MORGAN City,
Miss.
(mailing address)

description of formations encountered	from	to
CLAY	0	25
FINE SAND	25	40
SAND	40	53
SAND GRAVEL	53	113

WELL LOCATION:
sec. 25 T. 18 N. R. 2 E
1/2 miles N of MORGAN CITY
(distance) (direction) (nearest town)

WELL PURPOSE: IRR.
(home, irrigation, municipal, industrial)

WELL COMPLETION DATA:

- (1) diameter (inches) 16"
- (2) total depth (feet) 113'
- (3) static water level (feet) 17' below above top of ground.
- (4) casing BWC IR., 73'
(material) (depth)
16" if telescope see back.
(size)
- (5) screen 40', 73'
(length) (depth to top)
16", BWC INBOT
(size) (material)
- (6) pump 38, 2,000
(HP) (yield gpm)
DIESEL
(type power)
- (7) electric log No
(yes or no)
- (organization running log)
- (8) how well bottom plugged PLATE


CODED

JUN 27 1973

DRILLERS REMARKS:

If well telescopes please sketch and show depths.

GROUND LEVEL

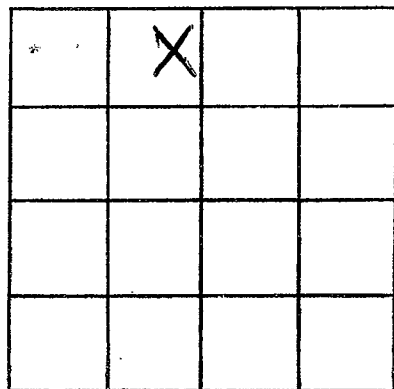

SECTION 25

Please indicate well location X.

ADDITIONAL INFORMATION

If more than one screen, show locations of each on sketch.