

LEFLORE  
M-4  
4-5-66

MISSISSIPPI BOARD OF WATER COMMISSIONERS


WATER WELL DRILLERS LOG

**CODED**

Date: APRIL 5, 1966, Driller: DELTA DRILLING Co County LEFLORE  
(Name)

(1) Owner of Land: <u>ROBERT MORTON</u> (Name)	Description & Color of Materials Sand, Clay, Red Clay, Shell, etc.	Thick- ness Feet	Depth Feet
<u>MORGAN CITY, MISS.</u> (Address)	gumbo	36	36
(2) Location: <u>1/2 W/2</u> , <u>SE 1/4</u> , Sec. <u>35</u> T <u>18</u> R <u>2</u> W _____ miles _____ of _____ (distance) (direction) (Nearest Town)	Sand	49	85
(3) Topography: _____ (Hilly) (Flat) (Level)	gravel	52	137
(4) Purpose of Well: <u>DOMESTIC</u> (Domestic Irrigation Municipal, Industrial, Other)	gumbo	30	167
Information upon completion of well:	Sand	95	262
(1) Diameter <u>3</u> inches.	gumbo	29	291
(2) Total Depth <u>1438</u> feet.	Sand	42	333
(3) Water Level <u>760</u> feet below top of ground.	gumbo	105	438
(4) Cased to <u>1418</u> , Size <u>700' 3"</u> / <u>735' 2"</u>	sand	82	520
(5) Screen: Size <u>2"</u> , Length <u>20'</u>	gumbo	57	577
(6) Were any formations sealed against pollution? _____ yes, _____ no.	Sand	101	678
If YES depth of formation _____	gumbo	91	769
Why _____	Shale w/Rocks -	50	819
Drillers Remarks: <u>17' LAP OF 2" IN</u>	green sand w/Rocks	80	899
<u>3" PIPE - FLOWS 600 g.p.m.</u>	Shale w/Rocks =	16	915
	sand w/Rocks -	64	979
	Shale	40	1019
	Sand w/ROCK	40	1059
	Shale w/ROCK	75	1134
	Sand	74	1208
	Shale	20	1228
	gumbo	22	1250
	sand	12	1262
	gumbo	20	1282
	Shale	13	1295
	gumbo	16	1311
	fine sand	22	1333
	Shale	26	1359
	Sand	79	1438

**CODED**

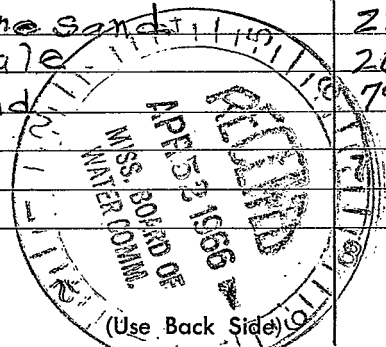

Well No.

1000  
1000  
1000