


M 11
11-28-61

WATER WELL DRILLERS LOG
CODED

Date: NOV. 28, 1961, Driller: DELTA DRILLING Co. County LEFLORE
(Name)

	Description & Color of Materials Sand, Clay, Red Clay, Shell, etc.	Thick- ness Feet	Depth Feet
(1) Owner of Land: <u>SYLVESTER JOHNSON</u> (Name) <u>MORGAN CITY, MISS.</u> (Address)	GUMBO + SAND	74	74
(2) Location: <u>NE 1/4, SW 1/4, Sec. 25 T18R2W</u> <u>1 1/4</u> miles <u>NW</u> , of <u>MORGAN CITY</u> (distance) (direction) (Nearest Town)	GRAVEL	46	110
(3) Topography: _____ (Hilly) (Flat) (Level)	SAND	58	168
(4) Purpose of Well: <u>DOMESTIC</u> (Domestic Irrigation Municipal, Industrial, Other)	GUMBO	160	328
Information upon completion of well:	SAND	32	360
(1) Diameter <u>3</u> inches.	SHALE	31	391
(2) Total Depth <u>815</u> feet.	SAND	28	419
(3) Water Level <u>WELL FLOWS</u> feet below top of ground.	SHALE W/SAND STREAKS	72	491
(4) Cased to <u>815'</u> , Size <u>3x2"</u>	SAND W/COCK	57	548
(5) Screen: Size <u>2</u> , Length <u>60 ± 2"</u> <u>PERFORATED PIPE.</u>	GUMBO	115	663
(6) Were any formations sealed against pollution? _____ yes, _____ no.	SAND W/6" ROCK -	24	687
If YES depth of formation _____	SHALE	24	711
Why _____	GREEN SAND	22	733
Drillers Remarks: _____	SHALE	26	759
_____	GREEN SAND	56	815

816
8 1/2
1 1/2

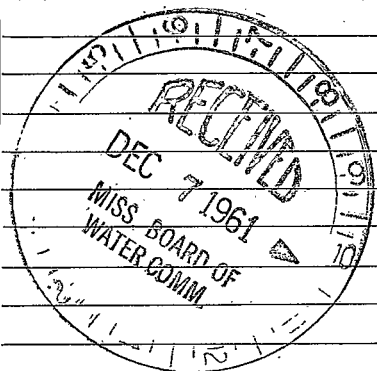

(Use Back Side)

Well No.

1910

1911

1912

1930