


M 12  
10-11-61

WATER WELL DRILLERS LOG CODED

Date: OCT. 11, 1961, Driller: DELTA DRILLING Co. County LEBLORE

(Name)

	Description & Color of Materials Sand, Clay, Red Clay, Shell, etc.	Thick- ness Feet	Depth Feet
(1) Owner of Land: <u>J. RUBLE COTHRAN</u> (Name) <u>MORGAN CITY, MISS.</u> (Address)	GUMBO	42	42
(2) Location: <u>N E 1/4, S W 1/4, Sec. 24 T 18 R 1 W</u> <u>1 1/2 miles NORTH</u> , of <u>MORGAN CITY</u> (distance) (direction) (Nearest Town)	SAND	63	105
(3) Topography: _____ (Hilly) (Flat) (Level)	GRAVEL	42	147
(4) Purpose of Well: <u>DOMESTIC</u> (Domestic Irrigation Municipal, Industrial, Other)	SAND	65	212
Information upon completion of well:	GUMBO	84	296
(1) Diameter: <u>3</u> inches.	SAND	146	442
(2) Total Depth: <u>1249</u> feet.	GUMBO	264	706
(3) Water Level: <u>WELL FLOWS</u> feet below top of ground. <u>3" - 682'</u>	GREEN SAND w/ 10" ROCK-	108	814
(4) Cased to: <u>1249</u> , Size: <u>2" - 557'</u>	SHALE	128	942
(5) Screen: Size: <u>2"</u> , Length: <u>30'</u>	BROWN SAND & GRAVEL STREAMS	128	1070
(6) Were any formations sealed against pollution? _____ yes, _____ no.	GUMBO <b>CODED</b>	82	1152
If YES depth of formation _____	FINE SAND-	59	1211
Why _____	WHITE SAND-	38	1249
Drillers Remarks: <u>20' LAP OF 2" IN 3" PIPE</u>			
<u>WELL FLOWS 90 GPM w/ 18# PRESSURE</u>			

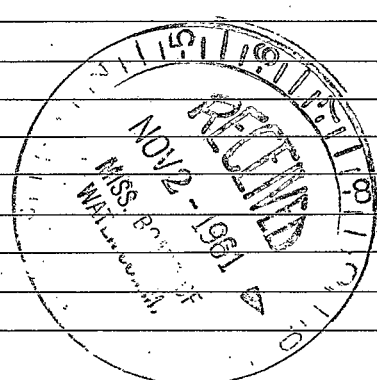

(Use Back Side)

Well No.

