

LEFLORE
M 25
7-26-74

MISSISSIPPI
BOARD OF WATER COMMISSIONERS
416 North State Street
Jackson, Mississippi 39201

CODED

WATER WELL DRILLERS LOG

7-26-74 19 19 BUTANE GAS CO. OF GREENWOOD LeFlore
date well completed firm name county well located

LANDOWNER:

Preston Hayes

Moorehead

(mailing address)

description of formations encountered

from to

CLAY	0	36
SAND	36	48
SAND & GRAVEL	48	163
CLAY	163	170
SAND & CLAY	170	354
SAND	354	487
SAND & SHALE	487	598
CLAY & SHALE	598	642
SHALE & ROCK	642	1007
FINE SAND	1007	1067
SAND & SHALE	1067	1085
SHALE	1085	1143
FINE SAND	1143	1199
SAND	1199	1278
SHALE	1278	1284

WELL LOCATION:

sec. 5 T. 18 N R. 2 E
S W
3 1/2 miles SW of BERCLAIR
(distance) (direction) (nearest town)

WELL PURPOSE: Home
(home, irrigation, municipal, industrial)

WELL COMPLETION DATA:

- (1) diameter (inches) 4 1/2
(2) total depth (feet) 1249
(3) static water level (feet) 22 below top of ground.

(4) casing Steel 1219
(material) (depth)

4 1/2 If telescope see back.
(size)

(5) screen 30 1219
(length) (depth to top)

2" Stainless
(size) (material)

(6) pump 20
(HP) (yield gpm)


(type power)

(7) electric log (yes or no)

(organization running log)

(8) how well bottom plugged Back Pressure Valve

CODED

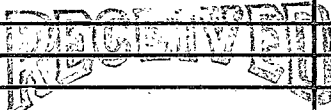

AUG - 8 1974

DRILLERS REMARKS:

MISS. BD. OF WATER COMMISSIONERS

If well telescopes please sketch and show depths.

GROUND LEVEL

705' 4" CASING →

114' 2" CASING →

30' 2" SCREEN →

		X	

SECTION 5

Please indicate well location X.

ADDITIONAL INFORMATION

If more than one screen, show locations of each on sketch.