

LEFLORE
M26
8-8-74

MISSISSIPPI
 BOARD OF WATER COMMISSIONERS
 416 North State Street
 Jackson, Mississippi 39201

CODED

WATER WELL DRILLERS LOG

8/8/74 19 19 EVIANE GAS CO. OF GREENWOOD Leflore
 date well completed firm name county well located

LANDOWNER:
EARNEST CONRAD
MOOREHEAD
 (mailing address)

WELL LOCATION:
 sec. 8 T. 18 N R. 2 E
6 miles SW of ETTA BEWA
 (distance) (direction) (nearest town)

WELL PURPOSE: Home
 (home, irrigation, municipal, industrial)

- WELL COMPLETION DATA:**
- (1) diameter (inches) 4 X 2
 - (2) total depth (feet) 398
 - (3) static water level (feet) 18 below above top of ground.
 - (4) casing Steel, 378,
 (material) (depth)
4 X 2 If telescope see back.
 (size)
 - (5) screen 20', 378
 (length) (depth to top)
2", Stainless
 (size) (material)
 - (6) pump 9/4, 20
 (HP) (yield gpm)
Elec
 (type power)
 - (7) electric log No
 (yes or no)
- (organization running log)
- (8) how well bottom plugged
Back Pressure Valve


description of formations encountered	from	to
<u>Clay</u>	<u>0</u>	<u>30</u>
<u>SAND</u>	<u>30</u>	<u>60</u>
<u>SAND & GRAVEL</u>	<u>60</u>	<u>130</u>
<u>CLAY</u>	<u>130</u>	<u>160</u>
<u>SAND CLAY SHALE</u>	<u>160</u>	<u>200</u>
<u>SAND + CLAY</u>	<u>200</u>	<u>320</u>
<u>FINE SAND</u>	<u>320</u>	<u>380</u>
<u>COARSE SAND</u>	<u>380</u>	<u>398</u>

DRILLERS REMARKS:

DISCOVERED
 SEP - 8 1974

If well telescopes please sketch and show depths.

GROUND LEVEL

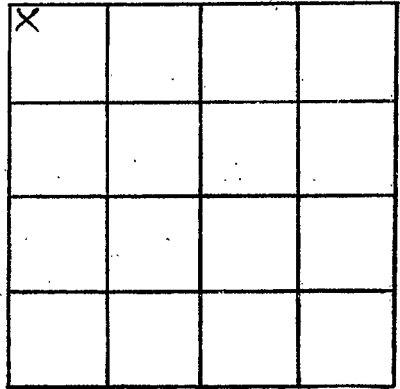

SECTION 8

Please indicate well location X.

ADDITIONAL INFORMATION

If more than one screen, show locations of each on sketch.