

LEFLORE

M 27

6-16-74

MISSISSIPPI BOARD OF WATER COMMISSIONERS  
416 North State Street  
Jackson, Mississippi 39201

CODED

WATER WELL DRILLERS LOG

JUNE 16 74

DYER WELL & IRRIGATION SERVICE

LEFLORE

date well completed

firm name

county well located

LANDOWNER:

COLUMBIA GULF TRANS.

GREENWOOD, MISS.  
(mailing address)

description of formations encountered

	from	to
CLAY	0	15
FINE SAND	15	34
COARSE SAND PER	34	
ROCK		56
COARSE SAND	56	
PER ROCK, GRAVEL		103

WELL LOCATION:

sec. 4 T. 18 N R. 2 E  
3/4 miles SO. of COLONY TOWN  
(distance) (direction) (nearest town)

WELL PURPOSE: TEST WELLD  
(home, irrigation, municipal, industrial)

WELL COMPLETION DATA:


- (1) diameter (inches) 12"
- (2) total depth (feet) 103'
- (3) static water level (feet) 16' below above top of ground.
- (4) casing BLUE IR. 63'  
(material) (depth)
- 12" if telescope see back.  
(size)
- (5) screen 40' 63'  
(length) (depth to top)
- 12" BLUE INGOT  
(size) (material)
- (6) pump 30 1500  
(HP) (yield gpm)
- TRACTOR  
(type power)
- (7) electric log No  
(yes or no)

CODED

(organization running log)

(8) how well bottom plugged PLATE

DRILLERS REMARKS:

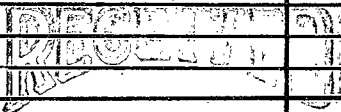


NOV 21 1974

MISS. Bd. OF WATER COMM

If well telescopes please sketch and show depths.

GROUND LEVEL

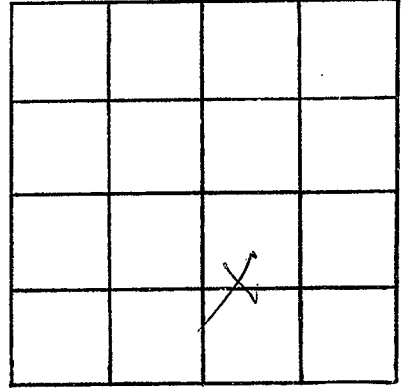

SECTION 4

Please indicate well location X.

ADDITIONAL INFORMATION

If more than one screen,  
show locations of each on sketch.