

Leflore
M28
11-15-62


MISSISSIPPI BOARD OF WATER COMMISSIONERS

WATER WELL DRILLERS LOG

CODED

Date: Nov. 15, 1962, Driller: DELTA DRILLING Co County LEFLORE
(Name)

(1) Owner of Land: <u>T. W. WHITE</u> (Name)	Description & Color of Materials Sand, Clay, Red Clay, Shell, etc.	Thick- ness Feet	Depth Feet
<u>MORGAN CITY, MISS.</u> (Address)	<u>GUMBO</u>	<u>44</u>	<u>44</u>
	<u>SAND</u>	<u>30</u>	<u>74</u>
	<u>GRAVEL</u>	<u>52</u>	<u>126</u>
(2) Location: <u>NW 1/4, SW 1/4, Sec. 11 T12R2W</u>	<u>GUMBO</u>	<u>104</u>	<u>230</u>
<u>_____</u> miles <u>_____</u> of <u>_____</u> (distance) (direction) (Nearest Town)	<u>SAND</u>	<u>61</u>	<u>291</u>
	<u>GUMBO</u>	<u>125</u>	<u>416</u>
(3) Topography: <u>_____</u> (Hilly) (Flat) (Level)	<u>SAND</u>	<u>30</u>	<u>446</u>
	<u>SHALE</u>	<u>31</u>	<u>477</u>
(4) Purpose of Well: <u>DOMESTIC</u> (Domestic Irrigation Municipal, Industrial, Other)	<u>SAND</u>	<u>48</u>	<u>525</u>
	<u>GUMBO</u>	<u>16</u>	<u>541</u>
	<u>SAND</u>	<u>91</u>	<u>632</u>
	<u>SHALE</u>	<u>12</u>	<u>644</u>
Information upon completion of well:	<u>GUMBO W/ROCK</u>	<u>104</u>	<u>748</u>
(1) Diameter <u>3</u> inches.	<u>SHALE W/ROCK</u>	<u>37</u>	<u>785</u>
(2) Total Depth <u>866</u> feet.	<u>GREEN SAND W/ROCK</u>	<u>10</u>	<u>795</u>
(3) Water Level <u>WELL FLOWS</u> feet below top of ground.	<u>SHALE</u>	<u>15</u>	<u>810</u>
(4) Cased to <u>845</u> , Size <u>3"</u>	<u>SAND</u>	<u>56</u>	<u>866</u>
(5) Screen: Size <u>3"</u> , Length <u>21'</u> <u>PERFORATED PIPE</u>			
(6) Were any formations sealed against pollution? <u>_____</u> yes, <u>_____</u> no.			
If YES depth of formation <u>_____</u>			
Why <u>_____</u>			
Drillers Remarks: <u>_____</u>			

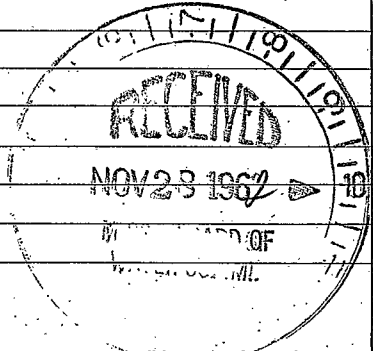

(Use-Back Side)

Well No.

