

LeFlore  
M29  
1-67

MISSISSIPPI  
BOARD OF WATER COMMISSIONERS  
416 North State Street  
Jackson, Mississippi 39201  
WATER WELL DRILLERS LOG

CODED

JAN. 3, 19 67 DELTA DRILLING CO. LEFLORE  
date well completed firm name county well located

LANDOWNER: J.J. HAYES-

RT. 1, BOX 156

ITTA BENA, MISS. 38930  
(mailing address)

WELL LOCATION: SE 1/4 - NW 1/4  
sec. 3 T. 18 N R. 2 W  
1 3/4 miles SW of BERCLAIR  
(distance) (direction) (nearest town)

WELL PURPOSE: DOMESTIC  
(home, irrigation, municipal, industrial)

WELL COMPLETION DATA:

- (1) diameter (inches) 3"
- (2) total depth (feet) 1206
- (3) static water level (feet) FLOWS below top of ground.
- (4) casing BLK STEEL 1186  
(material) (depth)  
3 1/2" if telescope see back.  
(size)
- (5) screen 20 1178  
(length) (depth to top)  
2" SS  
(size) (material)
- (6) pump  60  
(HP) (yield gpm)  
(type power)
- (7) electric log NO  
(yes or no)  
  
(organization running log)
- (8) how well bottom plugged BEEN  
PRESSURE VALVE

description of formations encountered

from to

gumbo	38	38
gravel	53	93
gumbo	101	194
Shale	30	224
Sand	86	310
Shale	22	332
Sand CODED	12	344
gumbo	51	395
Sand	24	419
gumbo	17	436
Shale	54	490
Sand w/rocks	62	552
Shale	20	572
gumbo	39	611
green sand w/rocks	33	644
Shale	14	658
green sand	30	688
Shale	30	718
GREEN SAND W/ROCKS	62	780
Shale w/rocks	70	850
green sand	54	904
Shale	58	1062
green sand	34	1096
gumbo	27	1123
Shale	27	1150
Sand	56	1206


DRILLERS REMARKS:



If well telescopes please sketch and show depths.



GROUND LEVEL

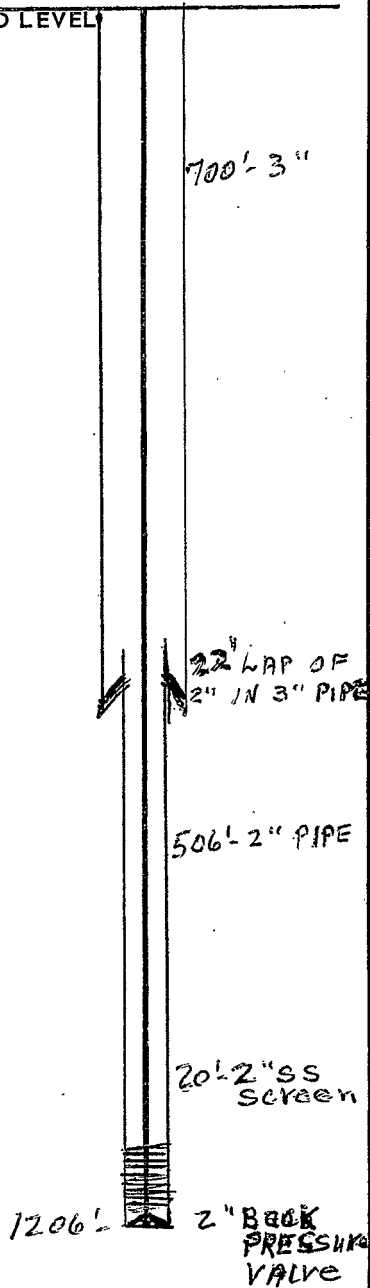

	X		

SECTION 3

Please indicate well location X.

ADDITIONAL INFORMATION

If more than one screen, show locations of each on sketch.