

LeFlore
 m 30
 4-67

MISSISSIPPI
 BOARD OF WATER COMMISSIONERS
 416 North State Street
 Jackson, Mississippi 39201

CODED

WATER WELL DRILLERS LOG

4/12 1967 Bortone Co. of Greenwood LeFlore
 date well completed firm name county well located

LANDOWNER: Sam Thompson

description of formations encountered	from	to
Top Soil	0	30
Clay & Sand	30	40
Coarse Sand & Fine Grd	40	103

(mailing address)

WELL LOCATION:

sec. 35 T 18 N R. 2 W
1 miles W of Morgan City
 (distance) (direction) (nearest town)

WELL PURPOSE: IRRIGATION
 (home, irrigation, municipal, industrial)

WELL COMPLETION DATA:

- (1) diameter (inches) 12"
- (2) total depth (feet) 103'
- (3) static water level (feet) 15' below above top of ground.
- (4) casing 12" 63'
 (material) (depth)
12" If telescope see back.
 (size)
- (5) screen 40 63'
 (length) (depth to top)
12" Black
 (size) (material)
- (6) pump 15 1600
 (HP) (yield gpm)
LPG
 (type power)
- (7) electric log No
 (yes or no)
- (organization running log)
- (8) how well bottom plugged
STEEL PLATE


CODED



DRILLERS REMARKS:

If well telescopes please sketch and show depths.

GROUND LEVEL

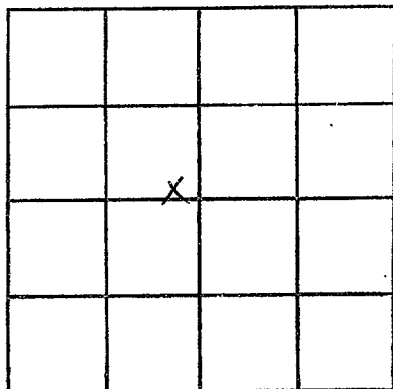

SECTION 35

Please indicate well location X.

ADDITIONAL INFORMATION

If more than one screen, show locations of each on sketch.