

LeFlore
M 31
5-67

MISSISSIPPI
 BOARD OF WATER COMMISSIONERS
 416 North State Street
 Jackson, Mississippi 39201

CODED

WATER WELL DRILLERS LOG

May 2, 67 19 Botawe Gas & Carbon LeFlore
 date well completed firm name county well located

LANDOWNER: Sam Thompson
Morgan City, Miss.
 (mailing address)


description of formations encountered	from	to
<u>Top Soil</u>	<u>0</u>	<u>31</u>
<u>Clay & Sand Strata</u>	<u>31</u>	<u>40</u>
<u>Coarse Sand & Gravel</u>	<u>40</u>	<u>80</u>

WELL LOCATION:
 sec. 35 T 18 N R. 21 E
1 miles W of Morgan City
 (distance) (direction) (nearest town)

WELL PURPOSE: Domestic
 (home, irrigation, municipal, industrial)


- WELL COMPLETION DATA:
- (1) diameter (inches) 2"
 - (2) total depth (feet) 80'
 - (3) static water level (feet) 15 below top of ground.
 - (4) casing 2" Poly. 60'
 (material) (depth)
2" If telescope see back.
 (size)
 - (5) screen 20', 60'
 (length) (depth to top)
2", Plastic
 (size) (material)
 - (6) pump 1/2, 5
 (HP) (yield gpm)
Electric
 (type power)
 - (7) electric log No
 (yes or no)
 (organization running log)
 - (8) how well bottom plugged
Beard Pressure Valve

DRILLERS REMARKS:

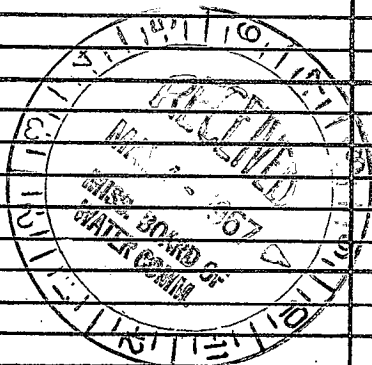

If well telescopes please sketch and show depths.

GROUND LEVEL

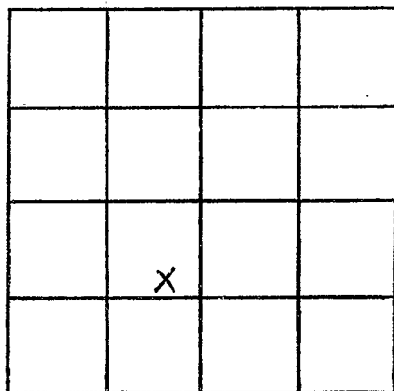

SECTION 35

Please indicate well location X.

ADDITIONAL INFORMATION

If more than one screen,
show locations of each on sketch.