

LEFLORE
M32
5-2-75

MISSISSIPPI
 BOARD OF WATER COMMISSIONERS
 416 North State Street
 Jackson, Mississippi 39201

CODE

WATER WELL DRILLERS LOG

5-2-75
 date well completed

⁰⁸⁷
 BUTANE GAS CO. OF GREENWOOD
 firm name


LeFlore
 county well located

LANDOWNER:	description of formations encountered	from	to
<u>MURPHEY BROS.</u>			
<u>Itta Bena</u> (mailing address)	<u>SAND & GRAVEL</u>	<u>40</u>	<u>100</u>
WELL LOCATION: sec. <u>7</u> T. <u>18N</u> R. <u>2E</u> <u>1/2</u> miles <u>SE</u> of <u>Colony Town</u> (distance) (direction) (nearest town)			
WELL PURPOSE: <u>IRR</u> (home, irrigation, municipal, industrial)			
WELL COMPLETION DATA:			
(1) diameter (inches)	<u>12"</u>		
(2) total depth (feet)	<u>100</u>		
(3) static water level (feet)	<u>17</u>		<u>below</u> top of ground
(4) casing <u>Steel</u>	<u>60</u>		
(material)	(depth)		
<u>12"</u>	if telescope see back.		
(size)			
(5) screen <u>40</u>	<u>60</u>		
(length)	(depth to top)		
<u>12"</u>	<u>Steel</u>		
(size)	(material)		
(6) pump <u>40</u>	<u>2000</u>		
(HP)	(yield gpm)		
<u>Electric</u>			
(type power)			
(7) electric log <u>NO</u>			
(yes or no)			
(organization running log)			
(8) how well bottom plugged <u>Steel Plate</u>			
DRILLERS REMARKS:			

RECEIVED
 MAY 19 1975

If well telescopes please sketch and show depths.

GROUND LEVEL

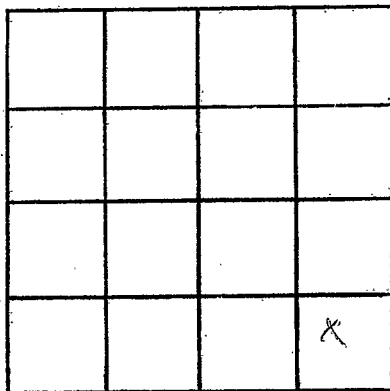

SECTION 4

Please indicate well location X.

ADDITIONAL INFORMATION

If more than one screen, show locations of each on sketch.