

Leflore
 No 33
 7-9-75

MISSISSIPPI
 BOARD OF WATER COMMISSIONERS
 416 North State Street
 Jackson, Mississippi 39201

WATER WELL DRILLERS LOG

BUTANE GAS CO. OF GREENWOOD


7-9-75 1975 date well completed
 Leflore firm name
 county well located

LANDOWNER:	description of formations encountered	from	to
JAMES MORGAN, JR.	CLAY	0	10
MORGAN City (mailing address)	SAND	10	50
	GRAVEL	50	135
WELL LOCATION:	SAND + CLAY	135	205
sec. 23 T. 18 N. R. 2 E 15 J	SHALE	205	367
2 miles N of Morgan City	SAND	367	562
(distance) (direction) (nearest town)	SHALE	562	667
WELL PURPOSE: Home	SHALE + ROCK	667	762
(home, irrigation, municipal, industrial)	SAND	762	790
WELL COMPLETION DATA:	SANDY SHALE	790	840
(1) diameter (inches) 4 X 2	SHALE + ROCK	840	875
(2) total depth (feet) 1196	SHALE, SAND + ROCK	875	898
(3) static water level (feet) 10 below top of ground.	SAND	898	918
(4) casing Steel 1166 (material) (depth)	SHALE + SAND	918	930
4 X 2 if telescope see back. (size)	SANDY SHALE + ROCK	930	1040
(5) screen 30 1166 (length) (depth to top)	SAND	1040	1075
2" Standless (size) (material)	SAND + SHALE	1075	1135
(6) pump 2 35 (HP) (yield gpm)	SAND	1135	1195
Elec. (type power)	SHALE	1195	1215
(7) electric log No (yes or no)			
(organization running log)			
(8) how well bottom plugged Lead Plug			
DRILLERS REMARKS:			

DISCOVERED
 JUL 29 1975

MISS. BD. OF WATER COMMISSIONERS

If well telescopes please sketch and show depths.

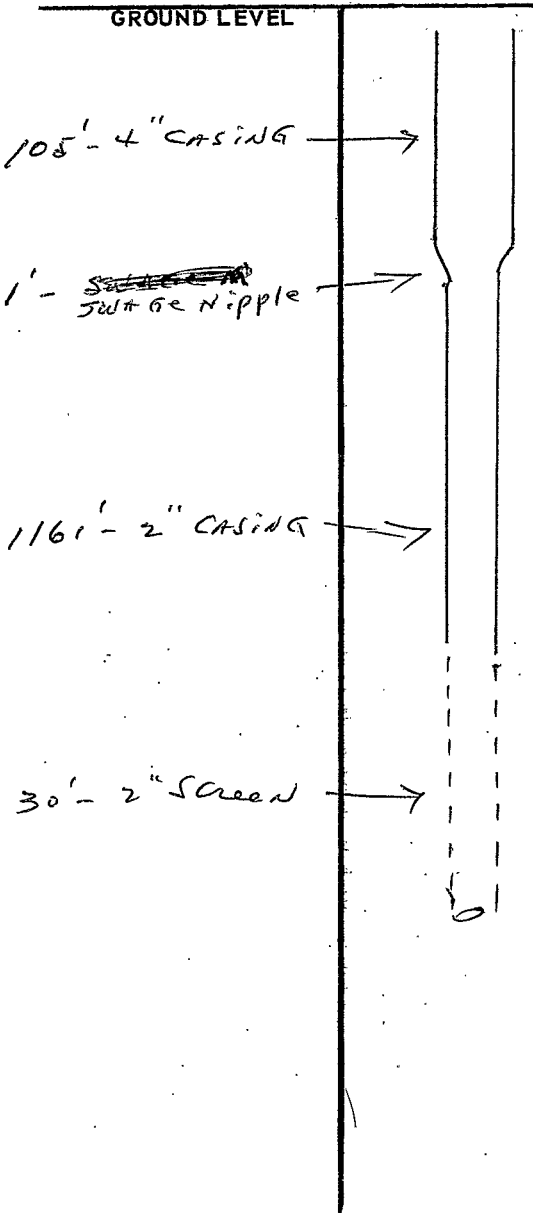

	X		

SECTION 23

Please indicate well location X.

ADDITIONAL INFORMATION

If more than one screen, show locations of each on sketch.