

LEFLORE

M 34

1-14-75

MISSISSIPPI
 BOARD OF WATER COMMISSIONERS
 416 North State Street
 Jackson, Mississippi 39201

CODED

WATER WELL DRILLERS LOG

January 14, 1975 Dyer-Sullivan, Inc. Leflore
 date well completed firm name county well located

LANDOWNER: B.D. Strain #2

Morgan City, Miss.

(mailing address)

description of formations encountered

from

to

Clay

0

33

Fine Sand

33

73

Sand & Gravel

73

113

WELL LOCATION:

sec. 27 T. 18 N R. 2 E
2 miles NW of Morgan City
 (distance) (direction) (nearest town)


WELL PURPOSE: Irrigation
 (home, irrigation, municipal, industrial)

CODED

WELL COMPLETION DATA:

- (1) diameter (inches) 16"
- (2) total depth (feet) 113
- (3) static water level (feet) 11 below above top of ground.
- (4) casing BLK Iron, 73',
 (material) (depth),
12" if telescope see back.
 (size)
- (5) screen 40', 73'
 (length) (depth to top)
16", BLK Ingot
 (size) (material)
- (6) pump 60 3000
 (HP) (yield gpm)
DIESEL
 (type power)
- (7) electric log No
 (yes or no)
- (organization running log)
- (8) how well bottom plugged Plate

DRILLERS REMARKS:

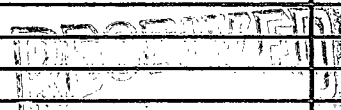

01/14/1975

MISS. Bd. of Water Comm.

If well telescopes please sketch and show depths.

GROUND LEVEL

	X		

SECTION 27

Please indicate well location X.

ADDITIONAL INFORMATION

If more than one screen,
show locations of each on sketch.