

Leflore
M 41
4-26-76

MISSISSIPPI
BOARD OF WATER COMMISSIONERS
416 North State Street
Jackson, Mississippi 39201

WATER WELL DRILLERS LOG

COPEL
Leflore

4-26 1976 Delta Water Supply ~~Bolivar~~
date well completed firm name county well located

LANDOWNER: Colony Town
R. T. Cooper
Memphis Tenn
(mailing address)

description of formations encountered	from	to
Top Soil	0	20
fine sand	20	31
Clay	31	42
Coarse sand & pea gravel	42	115
lit at bottom on clay		115

WELL LOCATION:
sec 4 T 18 N R 2 E
? S 2nd W
4 mi miles West of Maashead
(distance) (direction) (nearest town)

WELL PURPOSE: Irrigation
(home, irrigation, municipal, industrial)


- WELL COMPLETION DATA:
- (1) diameter (inches) 16"
 - (2) total depth (feet) 115'
 - (3) static water level (feet) 14' below top of ground.
 - (4) casing 16" Steel (material) (depth)
 - 1/2" if telescope see back. (size)
 - (5) screen 40' (length) (depth to top)
 - 16" Steel (size) (material)
 - (6) pump 60 2800 (HP) (yield gpm)
 - Diesel 440 (type power)
 - (7) electric log no (yes or no)
 - (organization running log)
 - (8) how well bottom plugged Sted Ratz

DRILLERS REMARKS:

RECEIVED
MAY - 7 1976
MISS. BD. OF WATER COMMISSIONERS

If well telescopes please sketch and show depths.

GROUND LEVEL

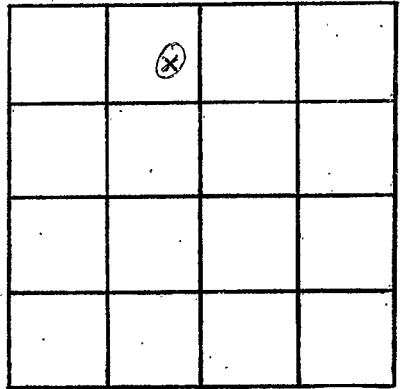

SECTION 4

Please indicate well location X.

ADDITIONAL INFORMATION

If more than one screen,
show locations of each on sketch.