

LEFLORE

MISSISSIPPI
BOARD OF WATER COMMISSIONERS
416 North State Street
Jackson, Mississippi 39201

CODED

M-49

7/31/80

7-31

1980 BUTANE GAS COMPANY

LEFLORE

date well completed

OF GREENWOOD

county well located

LANDOWNER

LEFLORE County School

description of formations encountered

from

to

Box 544

GREENWOOD Ms

(mailing address)

CLAY
CLAY & SAND
SAND & GRAVEL
1 60
60 80
80 105

WELL LOCATION:

sec 16 T 18 N R 2 E
S W
2 miles South of Colony Town
(distance) (direction) (nearest town)

WELL PURPOSE:

(home, irrigation, municipal, industrial)

WELL COMPLETION DATA:

- (1) diameter (inches) 4"
- (2) total depth (feet) 105
- (3) static water level (feet) 18 ^{below} _{above} top of ground. CODED
- (4) casing PVC 85' (material) (depth)
4" (size) if telescope see back.
- (5) screen 20' 85' (length) (depth to top)
4" PVC (size) (material)
- (6) pump 1 28 (HP) (yield gpm)
ELECTRIC (type power)
- (7) electric log (yes or no)

(organization running log)

- (8) how well bottom plugged BACK PRESSURE VALVE

DEPT. OF NATURAL RESOURCES
BUREAU OF LAND & WATER RESOURCES


AUG 11 1980

DRILLERS REMARKS:

RECEIVED

If well telescopes please sketch and show depths.

GROUND LEVEL

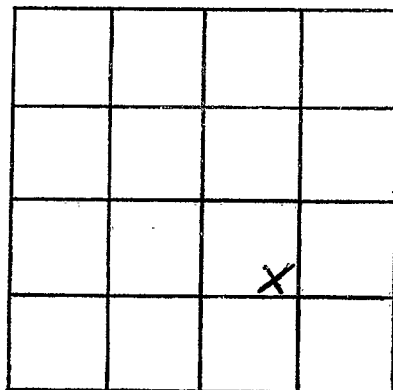

SECTION 16

Please indicate well location X.

ADDITIONAL INFORMATION

If more than one screen,
show locations of each on sketch.