

LEFLORE
M50
10/3/80

MISSISSIPPI
BOARD OF WATER COMMISSIONERS
416 North State Street
Jackson, Mississippi 39201

CODED

WATER WELL DRILLERS LOG

Oct 3 1980 BUTANE GAS COMPANY LEFLORE
date well completed OF GREENWOOD county well located

LANDOWNER:
Sam Thompson
Morgan City, MS
(mailing address)

description of formations encountered	from	to
CLAY	0	43
SAND	43	70
SAND & GRAVEL	70	99
FINE SAND	99	100

WELL LOCATION:
sec 34 T 18 N R 2 E
2 1/2 miles WEST of Morgan City
(distance) (direction) (nearest town)

CODED

WELL PURPOSE: IRRIGATION
(home, irrigation, municipal, industrial)

WELL COMPLETION DATA:

(1) diameter (inches) 16

(2) total depth (feet) 100'

(3) static water level (feet) 20 below top of ground.

(4) casing STEEL 60' (material) (depth)

(size) If telescope see back.

(5) screen 40' 60' (length) (depth to top)

16' STEEL (size) (material)

(6) pump 60 3000 (HP) (yield gpm)

DESEL (type power)

(7) electric log No (yes or no)

No (organization running log)

(8) how well bottom plugged STEEL PLATE

DEPT. OF NATURAL RESOURCES
BUREAU OF LAND & WATER RESOURCES


OCT 10 1980

RECEIVED

DRILLERS REMARKS:

If well telescopes please
sketch and show depths.

GROUND LEVEL

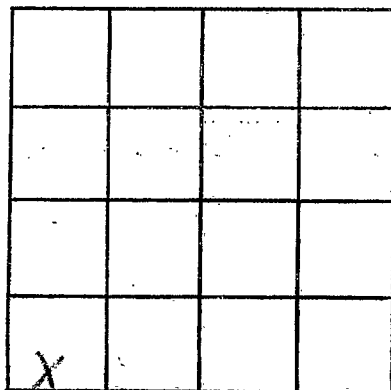

SECTION 34

Please indicate well location X.

ADDITIONAL INFORMATION

If more than one screen,
show locations of each on sketch.