

MISSISSIPPI DEPARTMENT OF NATURAL RESOURCES
Bureau of Land and Water Resources

Southport Mall
P.O. Box 10631

CODED

Jackson, Mississippi 39209
WATER WELL DRILLERS LOG

LEFLORE
M53
6-5-81

6-5-81
date well completed

BUTANE GAS COMPANY

OF GREENWOOD

Leflore
county well located

LANDOWNER:	description of formations encountered	from	to
<i>F.R. Morgan Jr.</i>	<i>Clay</i>	0	17
<i>Morgan City</i> (mailing address)	<i>Sand</i>	17	30
WELL LOCATION:	<i>Sand & Gravel</i>	30	40
sec. <u>30</u> T <u>18</u> N R <u>2</u> W	<i>Sand</i>	40	72
1 miles <u>N</u> of <u>Morgan City</u> (distance) (direction) (nearest town)	<i>Clay</i>	72	75
WELL PURPOSE: <u>Irrigation</u> (home, irrigation, municipal, industrial)	<i>Sand, fine Gravel</i>	75	83
WELL COMPLETION DATA:	<i>Sand</i>	83	89
(1) diameter (inches) <u>16"</u>	<i>Gravel</i>	89	100
(2) total depth (feet) <u>115</u>	<i>Sand & Gravel</i>	100	115
(3) static water level (feet) <u>20</u> below above top of ground.	<i>Rock</i>	115	
(4) casing <u>Steel</u> <u>75'</u> (material) (depth)			
<u>16</u> if telescope see back. (size)			
(5) screen <u>40'</u> <u>75'</u> (length) (depth to top)			
<u>16</u> <u>Steel</u> (size) (material)			
(6) pump <u>60</u> <u>2500</u> (HP) (yield gpm)			
<u>Diesel</u> (type power)			
(7) electric log (yes or no)			
(organization running log)			
(8) how well bottom plugged <u>Steel Plate</u>			
DRILLERS REMARKS:			

CODED


DEPT. OF NATURAL RESOURCES
BUREAU OF LAND & WATER RESOURCES

JUN 15 1991

RECEIVED

If well telescopes please sketch and show depths.

GROUND LEVEL

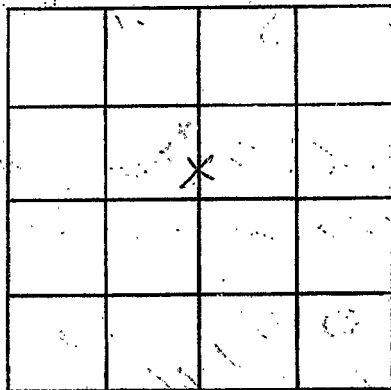

SECTION 30

Please indicate well location X.

ADDITIONAL INFORMATION

If more than one screen,
show locations of each on sketch.