

MISSISSIPPI DEPARTMENT OF NATURAL RESOURCES

Bureau of Land and Water Resources

Southport Mall

P.O. Box 10631

Jackson, Mississippi 39209

CODED

WATER WELL DRILLERS LOG

*Lefflore*  
*AM 57*

19 *Dyer Well*

firm name

county well located *Lefflore*

LANDOWNER: *Water Fellow III*

description of formations encountered

from

to

(mailing address)

WELL LOCATION:

sec *22 T. 18 N* *R 2 E*  
*5* miles *W* of *MORGAN W. MANLEY CITY MISSISSIPPI*  
(distance) (direction) (nearest town)

WELL PURPOSE:

(home, irrigation, municipal, industrial)

WELL COMPLETION DATA:

- (1) diameter (inches) *12"*
- (2) total depth (feet) *100*
- (3) static water level (feet) *18* below top of ground
- (4) casing *Steel 60*  
(material) (depth)  
*40'* if telescope see back.  
(size)
- (5) screen *40'* *40'*  
(length) (depth to top)  
*12"* *steel*  
(size) (material)
- (6) pump *60* *1000*  
(HP) (yield gpm)  
*diesel*  
(type power)
- (7) electric log *no*  
(yes or no)  
*no*  
(organization running log)
- (8) how well bottom plugged *plate*

<i>Clay</i>	<i>0</i>	<i>18</i>
<i>Fine Sand</i>	<i>18</i>	<i>38</i>
<i>Sand</i>	<i>38</i>	<i>58</i>
<i>Sand + gravel</i>	<i>58</i>	<i>100</i>

DEPT. OF NATURAL RESOURCES  
BUREAU OF LAND & WATER RESOURCES


FEB - 3 1983

RECEIVED

DRILLERS REMARKS:

If well telescopes please sketch and show depths.

GROUND LEVEL

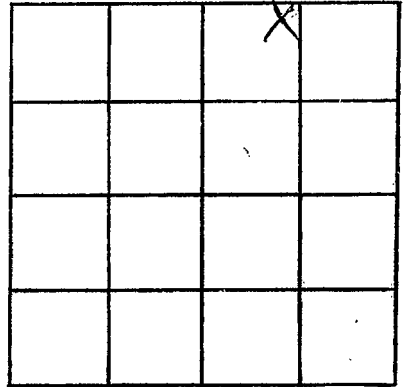

SECTION 22

Please indicate well location X.

ADDITIONAL INFORMATION

If more than one screen,  
show locations of each on sketch.