

Lefflore
A M 5 8

MISSISSIPPI DEPARTMENT OF NATURAL RESOURCES
 Bureau of Land and Water Resources
 Southport Mall
 P.O. Box 10631
 Jackson, Mississippi 39209
WATER WELL DRILLERS LOG

CODED

date well completed 19 June well firm name Well county well located Lefflore

LANDOWNER: Walker Pillow III
 (mailing address)

description of formations encountered	from	to
<u>Clay</u>	<u>0</u>	<u>20</u>
<u>Hard Sand</u>	<u>24</u>	<u>39</u>
<u>Sand</u>	<u>38</u>	<u>48</u>
<u>Sand & gravel</u>	<u>48</u>	<u>103</u>

WELL LOCATION:
 sec. 14 T. B N. S. R. 2 E. W.
6 miles W of Morgan City
 (distance) (direction) (nearest town)


WELL PURPOSE:
 (home, irrigation, municipal, industrial)

- WELL COMPLETION DATA:
- (1) diameter (inches) 12
 - (2) total depth (feet) 103
 - (3) static water level (feet) 18 below above top of ground.
 - (4) casing Steel 63
 (material) (depth)
 - _____ if telescope see back.
 (size)
 - (5) screen 40' 40'
 (length) (depth to top)
 - 12" steel
 (size) (material)
 - (6) pump 600 1000
 (HP) (yield gpm)
 - diesel
 (type power)
 - (7) electric log no
 (yes or no)
 - _____ no
 (organization running log)
 - (8) how well bottom plugged plate

DRILLERS REMARKS:

If well telescopes please sketch and show depths.

GROUND LEVEL

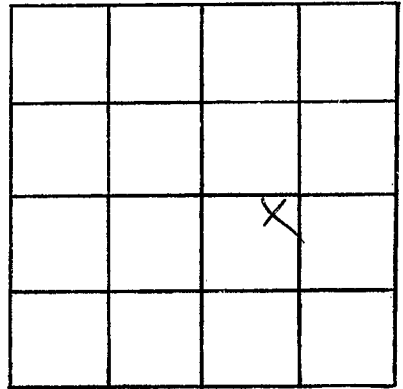

SECTION 14

Please indicate well location X.

ADDITIONAL INFORMATION

If more than one screen,
show locations of each on sketch.