

Lefflore
A 1959
11-82

MISSISSIPPI DEPARTMENT OF NATURAL RESOURCES
 Bureau of Land and Water Resources
 Southport Mall
 P.O. Box 10631
 Jackson, Mississippi 39209
WATER WELL DRILLERS LOG

CODED

11/82 19 Dyer Well Lefflore
 date well completed firm name county well located

LANDOWNER: <u>Walter Pillow</u>	Description of formations encountered	from	to
(mailing address)	<u>Clay</u>	<u>0</u>	<u>28</u>
WELL LOCATION: sec. <u>22</u> T. <u>18</u> (N) S R. <u>2</u> (E) W	<u>Fine Sand</u>	<u>18</u>	<u>48</u>
<u>5 1/2</u> miles <u>W</u> of <u>Morgan City</u> (distance) (direction) (nearest town)	<u>Sand + Gravel</u>	<u>49</u>	<u>78</u>
WELL PURPOSE: (home, irrigation, municipal, industrial)	<u>Fine Sand</u>	<u>78</u>	<u>85</u>
WELL COMPLETION DATA:	<u>Sand + Gravel</u>	<u>85</u>	<u>102</u>
(1) diameter (inches) <u>12</u> "			
(2) total depth (feet) <u>108</u>			
(3) static water level (feet) <u>18</u> below top of ground.			
(4) casing <u>Steel</u> , <u>68</u> (material) (depth)			
_____ if telescope see back. (size)			
(5) screen <u>40'</u> , <u>40'</u> (length) (depth to top)			
<u>12"</u> , <u>steel</u> (size) (material)			
(6) pump <u>60</u> , <u>1000</u> (HP) (yield gpm)			
<u>diesel</u> (type power)			
(7) electric log <u>no</u> (yes or no)			
_____ <u>no</u> (organization running log)			
(8) how well bottom plugged <u>plate</u>			
DRILLERS REMARKS:			


DEPT. OF NATURAL RESOURCES
 BUREAU OF LAND & WATER RESOURCES

FEB - 3 1983

RECEIVED

If well telescopes please sketch and show depths.

GROUND LEVEL

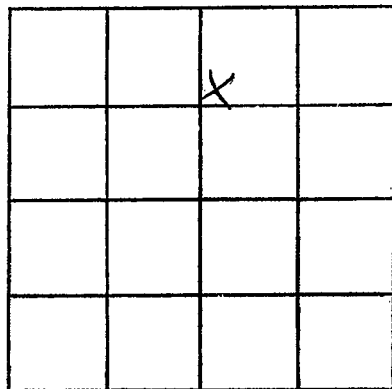

SECTION 22

Please indicate well location X.

ADDITIONAL INFORMATION

If more than one screen,
show locations of each on sketch.