

*Leflore*  
*M60*

MISSISSIPPI DEPARTMENT OF NATURAL RESOURCES  
 Bureau of Land and Water Resources  
 Southport Mall  
 P.O. Box 10631  
 Jackson, Mississippi 39209  
**WATER WELL DRILLERS LOG**

**CODED**

*5-3* 19 *82* *Dyer Well* *Leflore*  
 date well completed firm name county/well located

LANDOWNER: *Manhan*  
 (mailing address)

description of formations encountered	from	to
<i>Clay</i>	<i>0</i>	<i>40</i>
<i>Sand</i>	<i>40</i>	<i>48</i>
<i>Sand &amp; Gravel</i>	<i>48</i>	<i>108</i>

WELL LOCATION:  
 sec. *4* T *18* (N) R *2* E  
*3* miles *E* of *Moorhead*  
 (distance) (direction) (nearest town)

WELL PURPOSE:  
 (home, irrigation, municipal, industrial)

WELL COMPLETION DATA:


- (1) diameter (inches) *16*
- (2) total depth (feet) *108*
- (3) static water level (feet) *14* below top of ground.
- (4) casing *Steel*, *80* (material), (depth)  
*16* (size) if telescope see back.
- (5) screen *40*, *68* (length), (depth to top)  
*16* (size), *Mild Steel* (material)
- (6) *Deep* pump *40* (HP), *2000* (yield gpm)  
*diesel* (type power)
- (7) electric log *No* (yes or no)
- (8) how well bottom plugged *Plate*

DRILLERS REMARKS:

DEPT. OF NATURAL RESOURCES  
 BUREAU OF LAND & WATER RESOURCES  
 SEP 30 1982  
**RECEIVED**

If well telescopes please sketch and show depths.

GROUND LEVEL

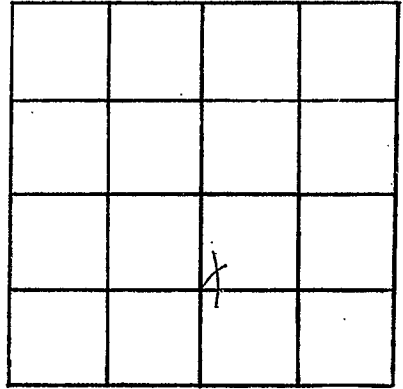

SECTION 4

Please indicate well location X.

ADDITIONAL INFORMATION

If more than one screen,  
show locations of each on sketch.