

MISSISSIPPI DEPARTMENT OF NATURAL RESOURCES

Bureau of Land and Water Resources

Southport Mall

P.O. Box 10631

Jackson, Mississippi 39209

WATER WELL DRILLERS LOG

CODED

LEFLORE
M61
9/30/83
Flng #111

Sep. 30 19 83 Bruce Berryman Leflore  
 date well completed firm name county well located  
 Greenwood, MS

LANDOWNER: Robinson  
 Deadening Plantation.  
 c/o P.O. Box 1579  
 Greenwood, MS 38930  
 (mailing address)

WELL LOCATION:  
 sec. 29 T 18 N R E  
 S 2 W Morgan  
 5 miles west of City  
 (distance) (direction) (nearest town)

WELL PURPOSE: Home  
 (home, irrigation, municipal, industrial)

WELL COMPLETION DATA:

(1) diameter (inches) 4" x 2"  
 (2) total depth (feet) 1142'  
 (3) static water level (feet) flow below top of ground - 126'  
 4 Blk. - 996'  
 (4) casing 2" Galv. - 996'  
 (material) (depth)  
 If telescope see back.  
 (size)  
 (5) screen 20' 1122'  
 (length) (depth to top)  
 2" .010 ga. Stainless steel  
 (size) (material)  
 (6) pump 2 50  
 (HP) (yield gpm)  
 Electric  
 (type power)  
 (7) electric log YES  
 (yes or no)  
 MS Bureau of Geology  
 (organization running log)  
 (8) how well bottom plugged B.P.V.

description of formations encountered	from	to
Clay	0	20
Sand	20	80
Sand & gravel	80	140
Clay	140	180
Sand	180	340
Clay	340	470
Sand	470	500
Fine sand	500	540
Coarse sand	540	590
Clay	590	780
Hard rock & clay	780	800
Clay	800	830
Sand	830	840
Hard rock & shale	840	860
Shale	860	870
Sand	870	880
Sand & str. shale	880	920
Shale & rocks	920	930
Sand	930	970
Shale	970	1000
Sand	1000	1029
Coarse sand	1029	1048
Shale	1048	1060
Clay	1060	1107
Sand	1107	1127
Coarse sand	1127	1157

CODED

DEPT. OF NATURAL RESOURCES  
BUREAU OF LAND & WATER RESOURCES


DEC - 9 1983

RECEIVED

DRILLERS REMARKS:

If well telescopes please  
sketch and show depths.

GROUND LEVEL

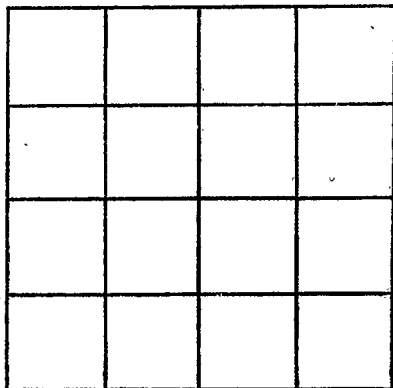

SECTION 29

Please indicate well location X.

ADDITIONAL INFORMATION

If more than one screen,  
show locations of each on sketch.