

MISSISSIPPI DEPARTMENT OF NATURAL RESOURCES

Bureau of Land and Water Resources

Southport Mall

P.O. Box 10631

Jackson, Mississippi 39209

WATER WELL DRILLERS LOG

CODED

M63
LEFLORE Co.
6-8-84

6-8
date well completed

1984 Dyer Well
firm name

LeFlore
county well located


LANDOWNER:	description of formations encountered	from	to
Mr. Muzar (mailing address)	Clay Fine Sand Sand & gravel	0 18 48	08 48 96
WELL LOCATION: sec. 28 T 12 N R 2 E S W 3 miles N of Magnolia (distance) (direction) (nearest town)			
WELL PURPOSE: <u>live</u> (home, irrigation, municipal, industrial)			
WELL COMPLETION DATA: (1) diameter (inches) <u>12"</u> (2) total depth (feet) <u>96</u> (3) static water level (feet) <u>21</u> below above top of ground. (4) casing <u>PVC</u> , <u>56</u> , (material) (depth) <u>12"</u> (size) If telescope see back. (5) screen <u>40ft</u> , <u>56</u> (length) (depth to top) <u>12"</u> <u>PVC</u> (size) (material) (6) pump <u>100</u> <u>2000</u> (HP) (yield gpm) <u>Dies</u> (type power) (7) electric log <u>No</u> (yes or no) <u>No</u> (organization running log) (8) how well bottom plugged <u>Steel pipe</u>			
DRILLERS REMARKS:			

CODED

1-14-85
JAN

If well telescopes please
sketch and show depths.

GROUND LEVEL

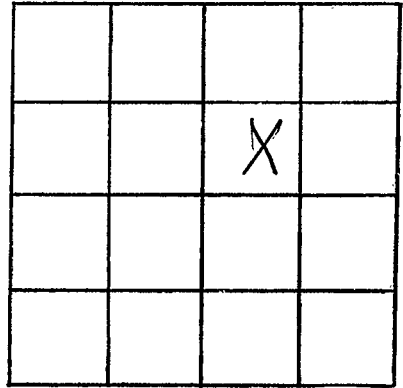

SECTION 28

Please indicate well location X.

ADDITIONAL INFORMATION

If more than one screen,
show locations of each on sketch.